

**THE COUNCIL OF THE BOROUGH OF MILTON KEYNES
(THE COUNCIL OF THE BOROUGH OF MILTON KEYNES)
(PARTS OF HIGH STREET, ST JOHN STREET AND TICKFORD
STREET, NEWPORT PAGNELL) (PROHIBITION AND
RESTRICTION OF WAITING) ORDER 2003) VARIATION ORDER
2017**

The Council of the Borough of Milton Keynes ("the Council") in exercise of its powers under sections 1(1), 2(1) and (2), 4(2), and Part IV of Schedule 9 of the Road Traffic Regulation Act 1984 ("the Act of 1984") and of all other enabling powers, and after consultation with the chief officer of Police in accordance with Part III of Schedule 9 to the Act of 1984, hereby makes the following Order:-

PART 1

IMPLEMENTATION AND CIATATION

1. This Order shall come into operation on the 3rd day of July 2017 and may be cited as "The Council of the Borough of Milton Keynes (The Council of the Borough of Milton Keynes) (Parts of High Street, St John Street and Tickford Street, Newport Pagnell) (Prohibition and Restriction of Waiting) Order 2003) Variation Order 2017".
2. Any reference in this Order to any enactment shall be construed as a reference to that enactment as amended by any subsequent enactment.
3. The plan annexed to this Order identifies the lengths of road subject to this Order, provided that where there is any inconsistency between the plan and Schedules it is the wording of the Schedules which shall prevail.
4. The plan annexed to this Order is hereby annexed to The Council of the Borough of Milton Keynes (Parts of High Street, St John Street and Tickford Street, Newport Pagnell) (Prohibition and Restriction of Waiting) Order 2003 and form part of that Order.

PART 2

VARIATIONS

5. The Council of the Borough of Milton Keynes (Parts of High Street, St John Street and Tickford Street, Newport Pagnell) (Prohibition and Restriction of Waiting) Order 2003 ("The Principal Order") is varied as provided by the following provisions of this Order:-

6. Item NW3 in Schedule 1 of the Principal Order is revoked and replaced by the following:-

ST JOHN STREET – SOUTH-WESTERN SIDE

NW3 From a point in line with the eastern kerbline of Silver Street for a distance of 15 metres in a south-easterly direction

7. Item RW8 in Schedule 2 of the Principal Order is revoked and replaced by the following:-

ST JOHN STREET – SOUTH-WESTERN SIDE

RW8 From a point 46 metres north-west of a point in line with the south-eastern kerbline of the access road into the car park (adjacent to the Library) for a distance of 6.6 metres in a north-westerly direction

8. Item RW9 in Schedule 2 of the Principal Order is revoked and replaced by the following:-

ST JOHN STREET – SOUTH-WESTERN SIDE

RW9 From a point 25 metres north-west of a point in line with the south-eastern kerbline of the access road into the car park (adjacent to the Library) for a distance of 39 metres in a south-easterly direction

9. Item RW11 in Schedule 2 of the Principal Order is revoked and replaced by the following:-

ST JOHN STREET – SOUTH-WESTERN SIDE

RW11 From a point 19.7 metres south-east of a point in line with the south-eastern kerbline of the access road into the car park (adjacent to the Library) for a distance of 43 metres in a south-easterly direction

10. The following items are inserted into Schedule 1 of the Principal Order:-


ST JOHN STREET – SOUTH-WESTERN SIDE

NW5 From a point 25 metres north-west of a point in line with the south-eastern kerbline of the access road into the car park (adjacent to the Library) for a distance of 23 metres in a north-westerly direction (following the kerbline)

ST JOHN STREET – SOUTH-WESTERN SIDE

NW6 From a point 14 metres south-east of a point in line with the south-eastern kerbline of the access road into the car park (adjacent to the Library) for a distance of 5.7 metres in a south-easterly direction

MAP FOR ORDER

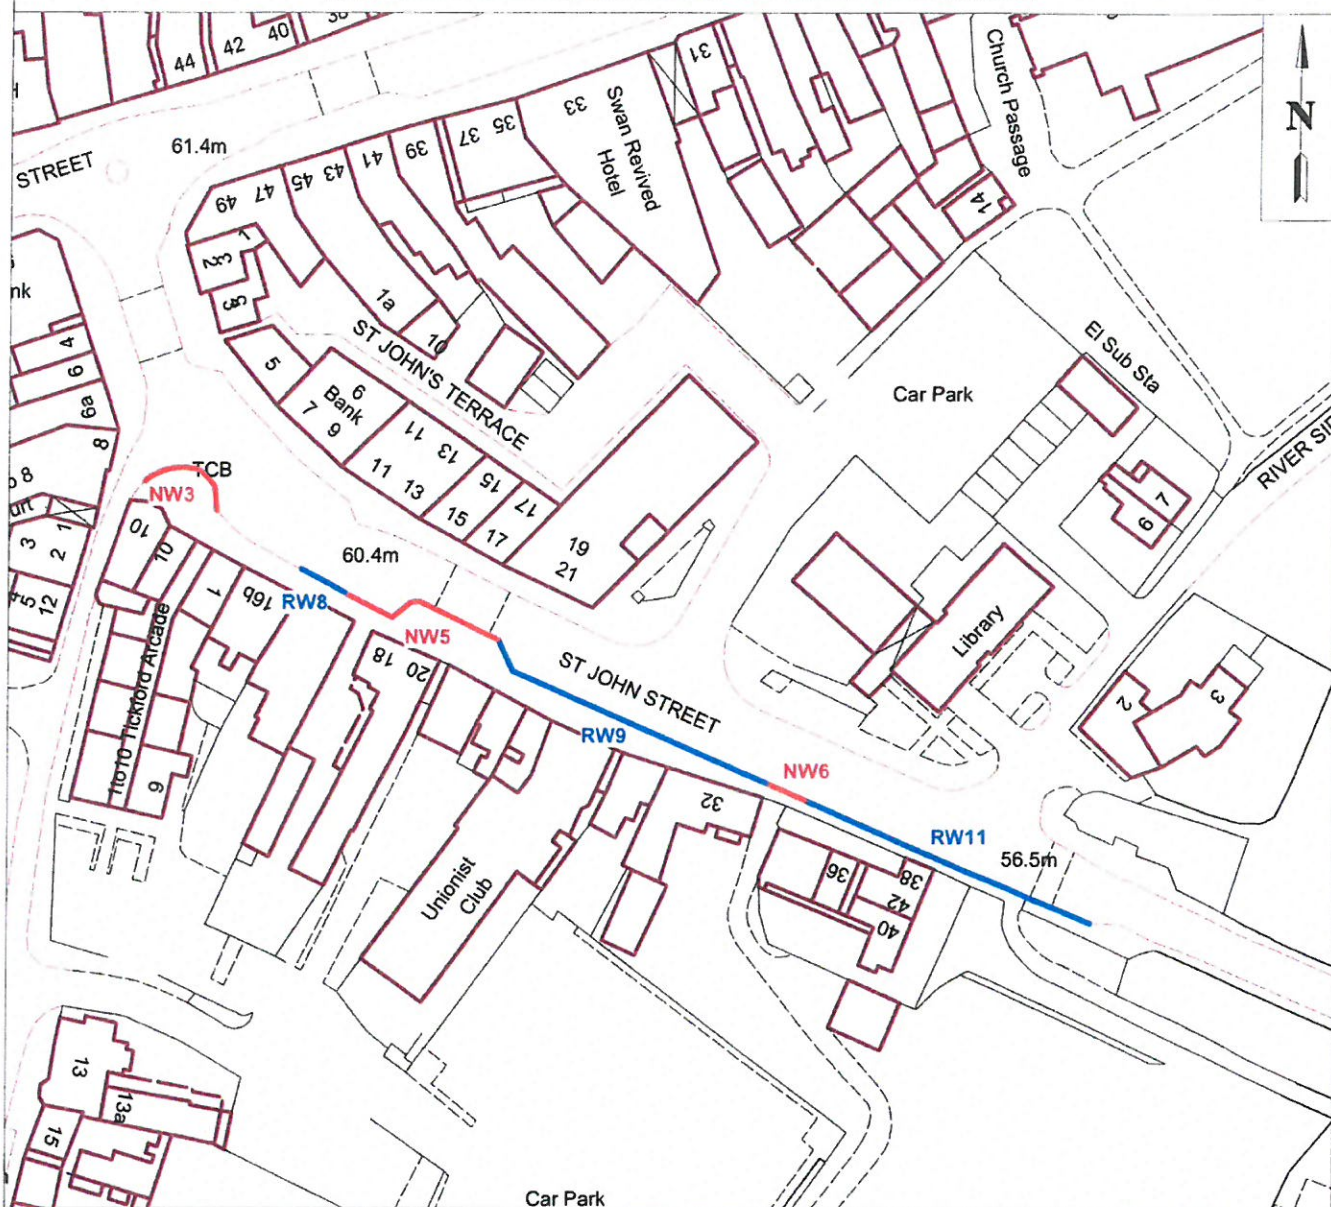

- No waiting at any time restriction
- Waiting to limited to 1 hour, no return within 1 hour (Monday to Saturday, 8am to 6pm)
- NW3 TRO reference number
- RW8 TRO reference number

0 3,968
centimeters
Scale: 1:967.7

Map referred to in The Council of the Borough of Milton Keynes (The Council of the Borough of Milton Keynes) (Parts of High Street, St John Street and Tickford Street, Newport Pagnell) (Prohibition and Restriction of Waiting) Order 2003) Variation Order 2017

The Common Seal of the Council of the Borough of Milton Keynes was hereunto affixed in the presence of:

[Signature]

Service Director
Legal & Democratic Services
& Monitoring Officer



23664

~~HEAD OF LEGAL SERVICES - LITIGATION & CHILD PROTECTION~~

PART 3

REVOCATIONS


11. The following Order is HEREBY REVOKED to the extent stated below:-

THE COUNCIL OF THE BOROUGH OF MILTON KEYNES (PARTS OF HIGH STREET, ST JOHN STREET AND TICKFORD STREET, NEWPORT PAGNELL) (PROHIBITION AND RESTRICTION OF WAITING) ORDER 2003

Item RW10 in Schedule 2 IS HEREBY REVOKED IN ITS ENTIRETY

Item LW1 in Schedule 3 IS HEREBY REVOKED IN ITS ENTIRETY

THE COMMON SEAL of the **COUNCIL OF THE BOROUGH OF MILTON KEYNES** as hereunto affixed this 27th day of June 2017 in the presence of:-

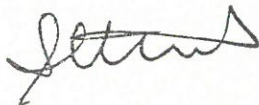

2366

.....
~~HEAD OF LEGAL SERVICES – LITIGATION & CHILD PROTECTION~~

Service Director
Legal & Democratic Services
& Monitoring Officer