No part of this drawing or data file may be reproduced without the prior written permission of the Head of Capital Programmes or approved representative.
This map is reproduced from Ordnance Survey material with the permission of Ordnance Survey on behalf of the Controller of Her Majesty's Stationery Office © Crown copyright and database rights 2016. Ordnance Survey 100019568.

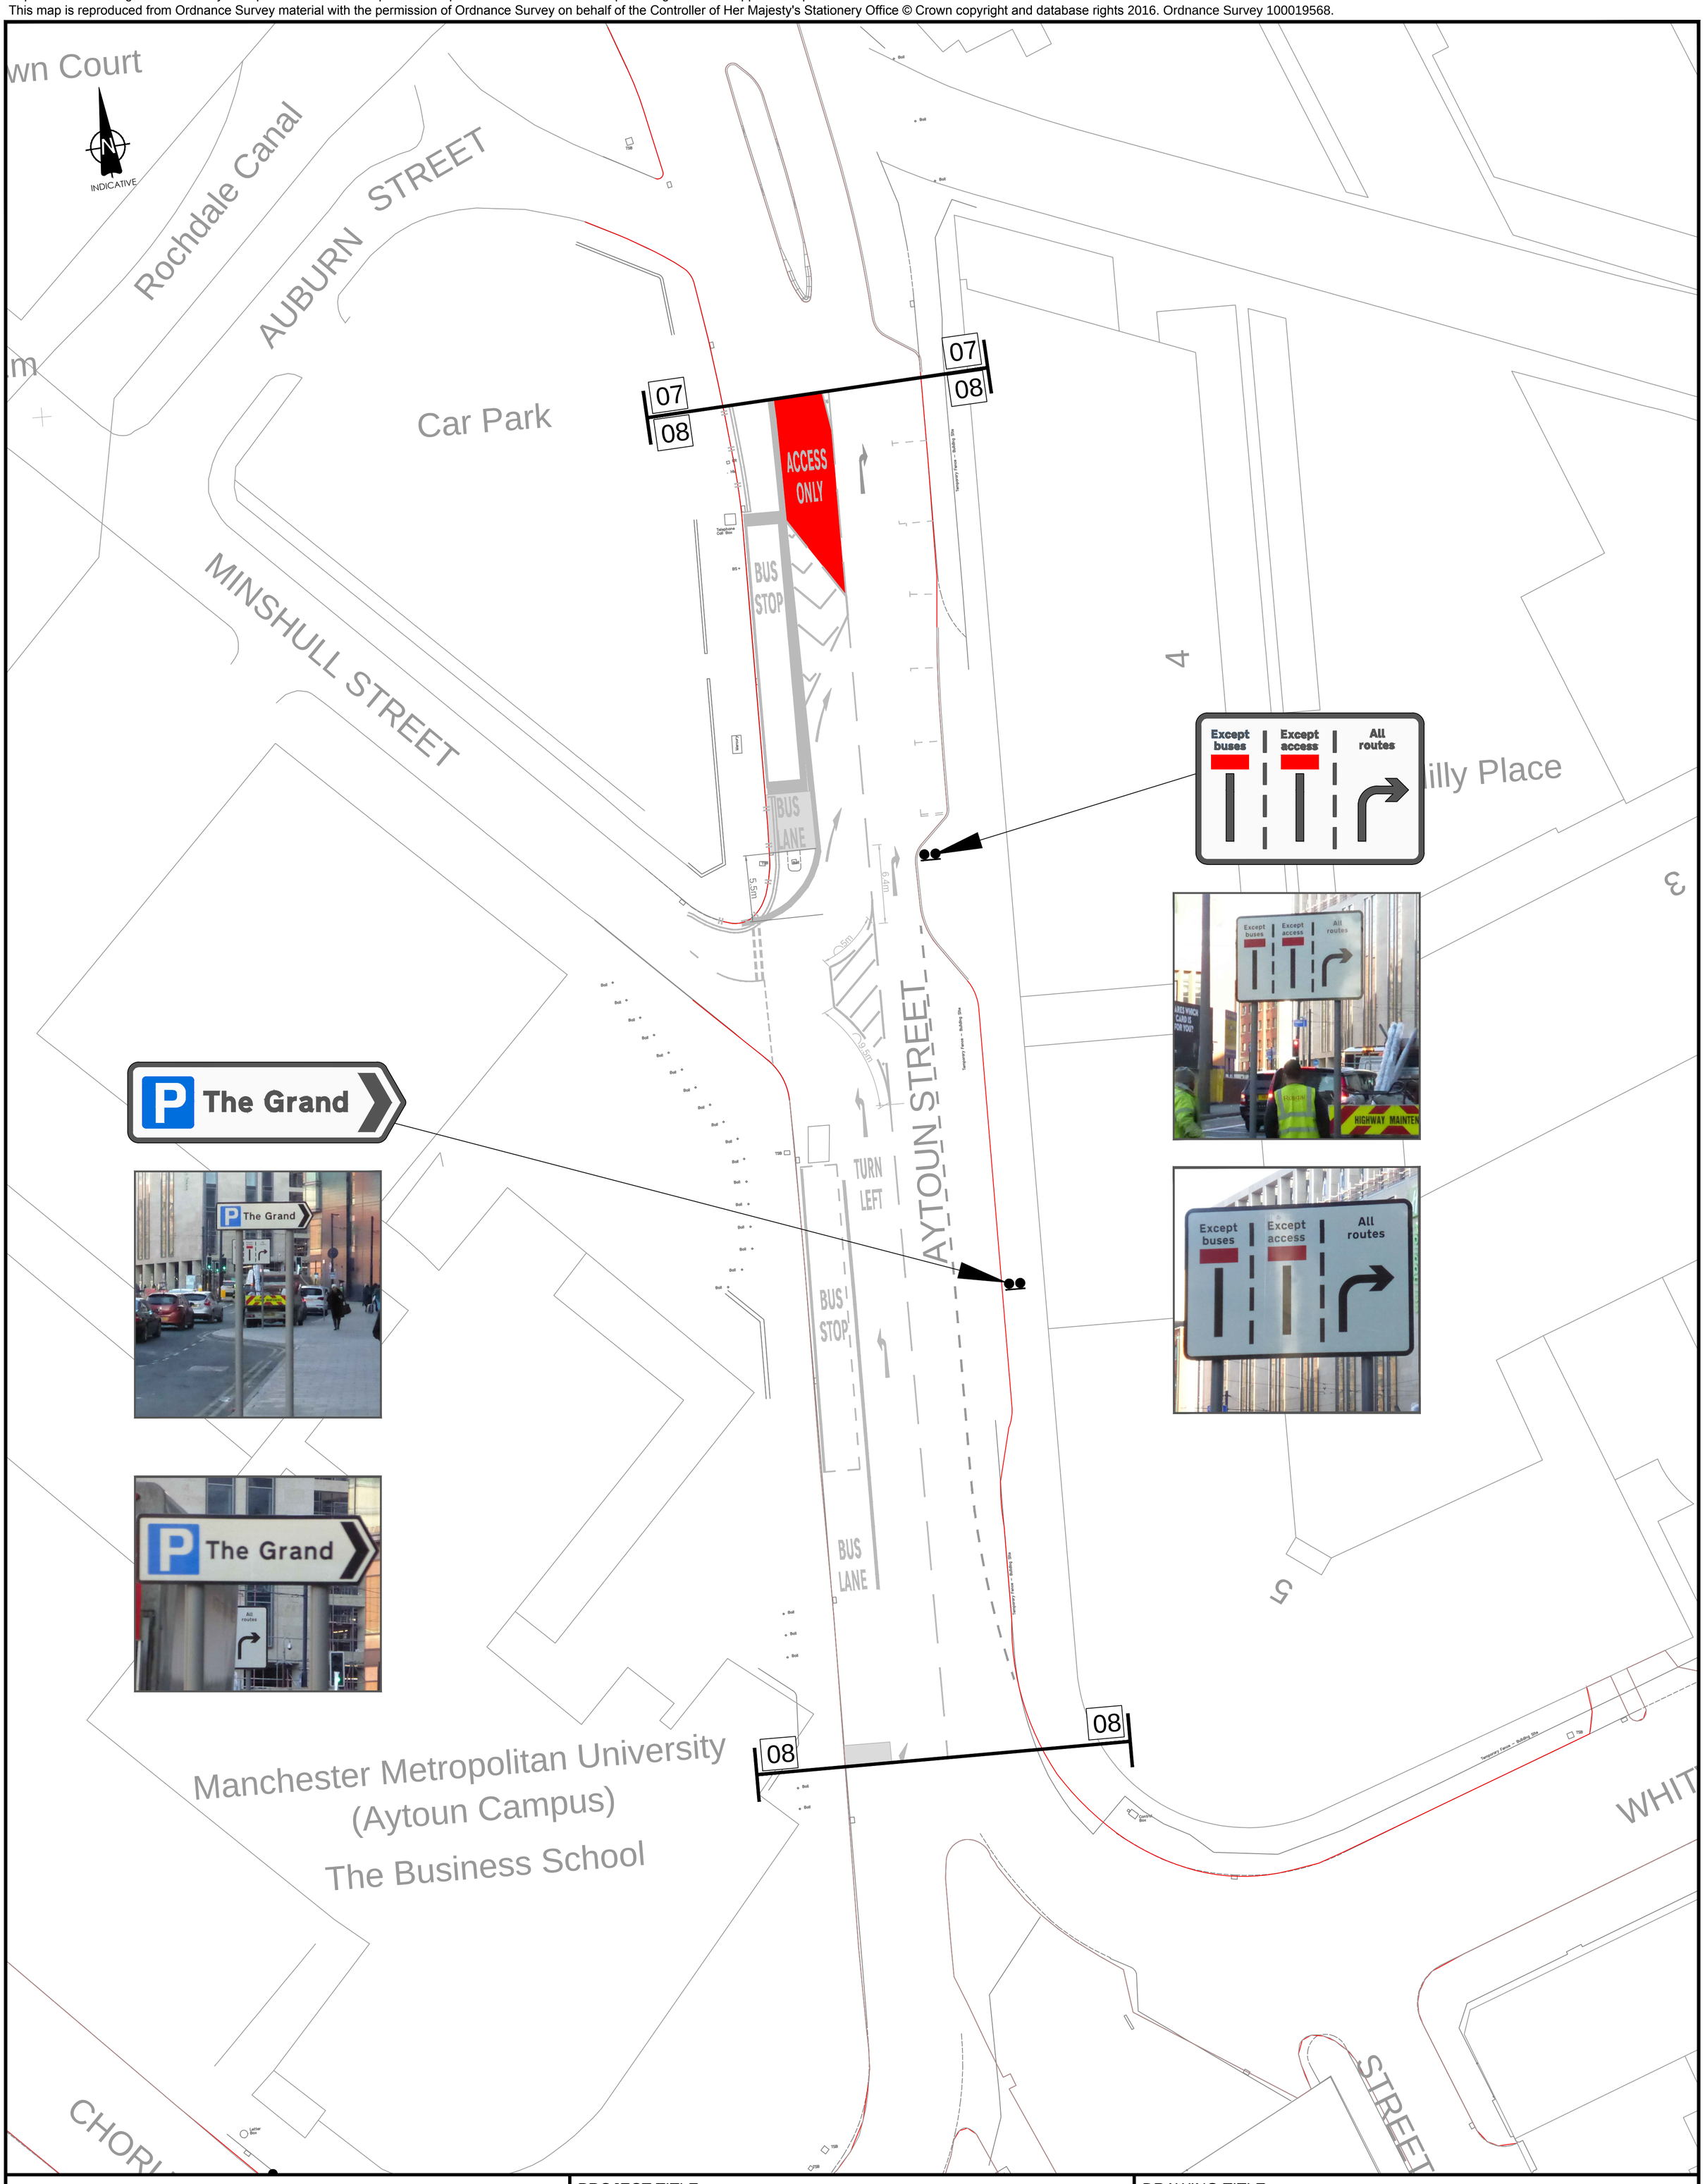

MANCHESTER CITY COUNCIL

Capital Programmes & Property
Growth & Neighbourhoods Directorate
PO Box 532
Town Hall
Manchester M60 2LA

PROJECT TITLE
Bus Priority Packages
Regional Centre
Traffic Management

DRAWING TITLE
As Built
Road Markings
And Traffic Signs
Sheet 8 of 9

SIZE	SCALE	DATE	DRAWN	CHECKED	APPROVED	DRAWING NUMBER	REV
A3	1:500	17-03-2016	AE	SC	MW	60336529/RC/PORT/TM/08	

CAD File : F:\Projects\Traffic - MCC Regional Centre Bus Priority Package\PORTLAND STREET PACKAGE\CAD\20160223_sheet8.dwg
0 10 mm