

**DONCASTER BOROUGH COUNCIL  
(VARIOUS ROADS DONCASTER)  
(PARKING, STOPPING, WAITING AND LOADING CONSOLIDATION)  
ORDER 2008  
(AMENDMENT NO. 51 ) ORDER 2009 10**

Doncaster Borough Council ("the Council") in exercise of its powers under Section 1(1), 2(1) to (3), 4(2) and Part IV of Schedule 9 of the Road Traffic Regulation Act 1984 ("the Act") and of all other enabling powers and after consultation with the Chief Officer of Police in accordance with Part III of Schedule 9 to the Act hereby makes the following Order:-

1 The Doncaster Borough Council (Various Roads Doncaster) (Parking Stopping Waiting and Loading Consolidation) Order 2008 shall have effect as though:-

(i) the following items were deleted from Schedule 1.02 of the Order no waiting at any time in the Doncaster Residents Permit Priority Parking Schemes:-

- CHRIST CHURCH ROAD North East Side
- (vii) From a point 16 metres south east of its junction with the south eastern kerbline of Copley Road to a point 17 metres north west of its junction with the north western kerbline of Copley Road
  - (viii) From its junction with the south eastern kerbline of Dockin Hill Road for a distance of 15 metres in a south easterly direction
- South West Side
- (vi) From a point 16 metres south east of its junction with the south eastern kerbline of Copley Road to a point 17 metres north west of its junction with the north western kerbline of Copley Road

And the following items were substituted in lieu thereof:-

- CHRIST CHURCH ROAD North East Side
- (vii) From a point 16 metres south east of its junction with the south eastern kerbline of Copley Road in a north westerly direction to a point 15 metres north west of its junction with the north western kerbline of Copley Road
  - (viii) From its junction with the south eastern kerbline of Dockin Hill Road for a distance of 19 metres in a south easterly direction
- South West Side
- (vi) From a point 16 metres south east of its junction with the

south eastern kerbline of Copley Road in a north westerly direction to a point 15 metres north west of its junction with the north western kerbline of Copley Road

(ii) and the following items were deleted from Schedule 8.01 Residents Permit Priority Parking Scheme; Parking Place with exemption for Permit Holders in the Doncaster Residents Priority Parking Scheme

Parts of Road authorised to be used as street parking place		Position in which vehicles may wait	Class of vehicle	Days of operation of Parking Places	Maximum period for which vehicle may wait
CHRIST CHURCH ROAD North East Side					
(vi)	From a point 8 metres north east of its junction with the north western kerbline of Highfield Road for a distance of 108 metres in a north westerly direction	Wholly within the limits of the parking place and parallel to the kerb	Invalid carriage motor car motor cycle Goods vehicles not exceeding 30 cwt unladen	On any day other than a Sunday between 8.00 a.m. and 6.00 p.m.	One hours return prohibited within two hours


(iii) and the following items were included in Schedule 8.01 Residents Permit Priority Parking Scheme; Parking Place with exemption for Permit Holder in the Doncaster Residents Priority Parking Scheme:-

Parts of Road authorised to be used as street parking place		Position in which vehicles may wait	Class of vehicle	Days of operation of Parking Places	Maximum period for which vehicle may wait
CHRIST CHURCH ROAD South West Side					
(vi)	From a point 15 metres north west of its junction with the northern kerbline of Copley Road for a distance of 18 metres in a north westerly direction	Wholly within the limits of the parking place and parallel to the kerb	Invalid carriage motor car motor cycle Goods vehicles not exceeding 30 cwt unladen	On any day other than a Sunday between 8.00 a.m. and 6.00 p.m.	One hours return prohibited within two hours

2 This Order shall come into operation on the 8<sup>th</sup> day of february 20~~09~~10 and may be cited as the "Doncaster Borough Council (Various Roads Doncaster) (Parking Stopping Waiting and Loading Consolidation) Order 2008 (Amendment No.51 ) Order 20~~09~~10".

GIVEN under the Common Seal of the Doncaster Borough Council this 3<sup>rd</sup> day of february 20~~09~~10


THE COMMON SEAL of DONCASTER )  
BOROUGH COUNCIL was hereunto affixed )  
In the presence of:- )

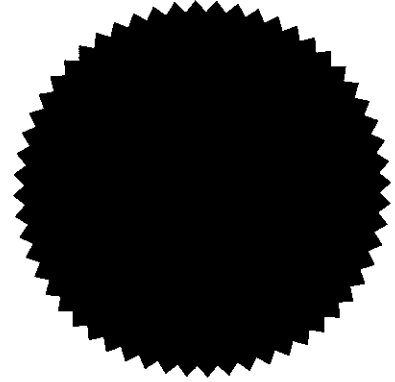

Authorised by the Acting Director of Legal and Democratic Services  
No. in Seal Register 57954



© Crown copyright. All rights reserved (1000019782) (2009)

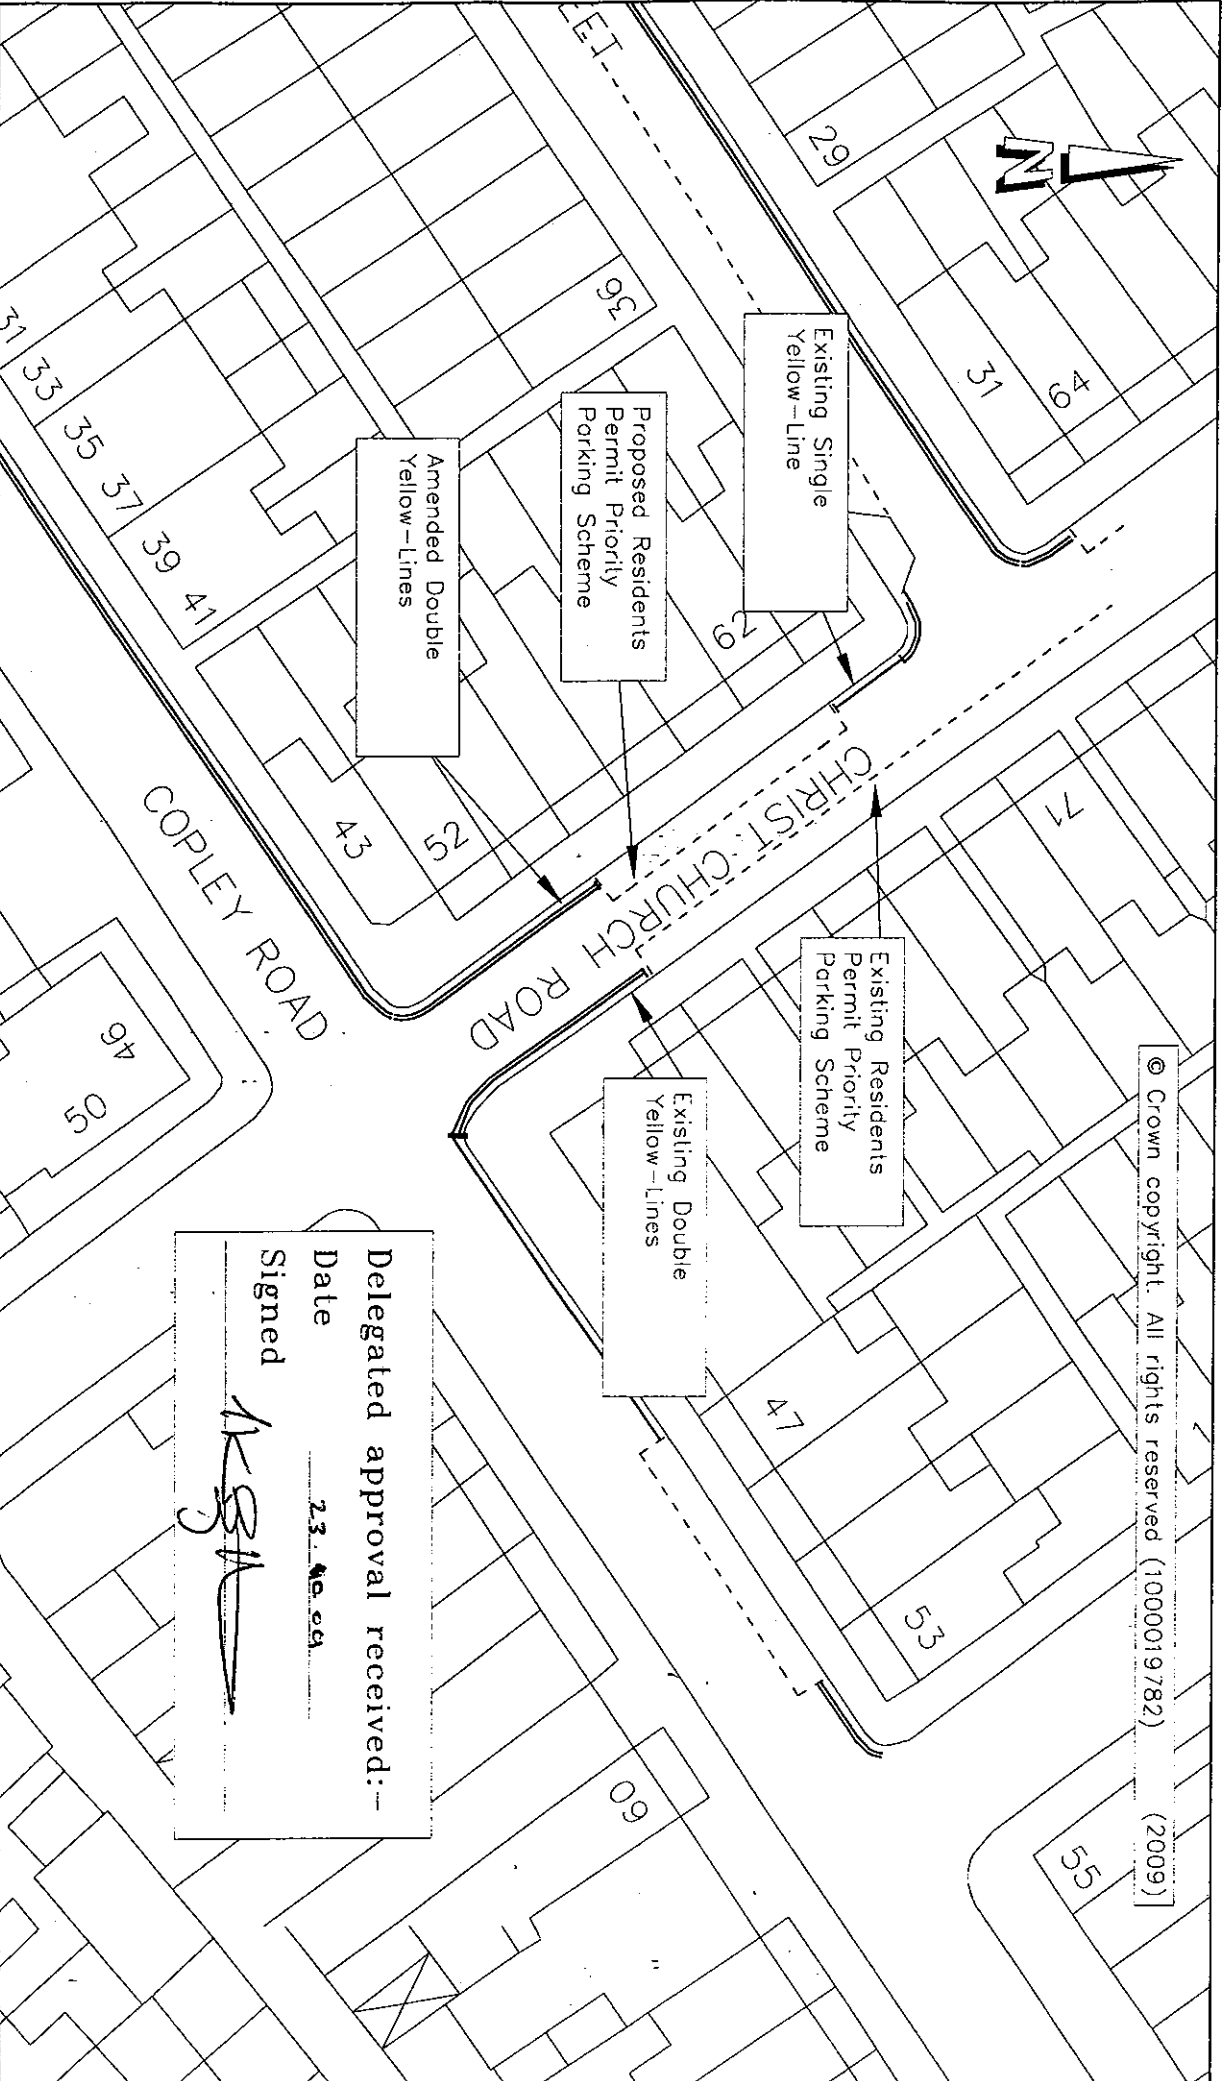

Delegated approval received:--  
Signed *[Signature]*

Doncaster MBC  
Scarborough House, Chequer Road  
DONCASTER DN1 2DB

TITLE:  
Extension of Doncaster Resident Priority  
Parking Scheme  
Christ Church Road

DATE: 08/10/09  
SCALE: N.T.S  
DRAWING NO: 45001/740