

TEST VALLEY BOROUGH COUNCIL

THE BOROUGH OF TEST VALLEY
(VARIOUS ROADS, ANDOVER)
(PROHIBITION AND RESTRICTION OF WAITING)
(NO.1) ORDER 1990

TEST VALLEY BOROUGH COUNCIL

THE BOROUGH OF TEST VALLEY (VARIOUS ROADS, ANDOVER)
(PROHIBITION AND RESTRICTION OF WAITING) ORDER 1990

The Council of the Borough of Test Valley (hereinafter referred to as "the Council") pursuant to arrangements made under section 101 of the Local Government Act 1972 with the Council of the County of Hampshire in exercise of the powers of the said County Council under section 1(1) and (2) and 2 (1) to (3) and Part IV of Schedule 9 to the Road Traffic Regulation Act 1984 (hereinafter referred to as "the Act") and of all other enabling powers, after consultation with the Chief Officer of Police in accordance with Part III of Schedule 9 to the Act, hereby make the following Order:-

1. This Order shall come into operation on 2nd July 1990 and may be cited as the Borough of Test Valley (Various Roads, Andover) (Prohibition and Restriction of Waiting) (No.1) Order 1990.
2. The Orders specified in Part 1 of Schedule 1 hereto are hereby revoked to the extent indicated in the second column of that Schedule and the Order specified in Part 2 of Schedule 1 is hereby amended as indicated in the second column of that Schedule.
3. In this Order:-

"authorised cab rank" means any area of carriageway which is comprised within and indicated by a road marking complying with diagram 1028.1 in Schedule 2 to the Traffic Signs Regulations and General Directions 1981;

"disabled person's badge" has the same meaning as in the Disabled Persons (Badges for Motor Vehicles) Regulations 1975;

"parking disc" means a disc, issued by a local authority, complying with the requirements of the British Standard Specification for Parking Discs (BS No. 4631: 1970), but coloured orange, and capable of showing the quarter hour period during which a period of waiting begins; and

"relevant position" means -

(a) in the case of a vehicle fitted with a front windscreen, the disabled person's badge is exhibited thereon with the obverse side facing forwards on the near side of and immediately behind the windscreen; and

(b) in the case of a vehicle not fitted with a front windscreen, the disabled person's badge is exhibited in a conspicuous position on the front or near side of the vehicle.

4. Save as provided in Article 5 of this Order no person shall, except upon the direction of or with the permission of a police constable in uniform or a traffic warden, cause or permit any vehicle to wait:

(1) at any time on any day in the lengths of roads specified in Schedule 2 to this Order;

(2) between the hours of 9.00am and 6.00pm on any day on any of the sides of road specified in Schedule 3 to this Order.

(3) between the hours of 9.00am and 6.00pm on any day other than a Sunday in the lengths of roads specified in Schedule 4 to this Order for a longer period than one hour or if a period of less than two hours has elapsed since a previous period of waiting by the same vehicle in the same length of road.

- (4) between the hours of 2.30pm and 3.15pm on any day other than Saturdays or Sundays in the lengths of road specified in Schedule 5 to this Order.
5. (1) Nothing in Article 4 of this Order shall render it unlawful to cause or permit any vehicle to wait in the lengths of road or on the side of road referred to therein for so long as may be necessary to enable -
- (a) a person to board or alight from the vehicle;
 - (b) the vehicle, if it cannot conveniently be used for such purpose in any other road, to be used in connection with any of the following operations, namely -
 - (i) building, industrial or demolition operations;
 - (ii) the removal of any obstruction to traffic
 - (iii) the maintenance, improvement or reconstruction of the said lengths of roads or side of road;
 - or
 - (iv) the laying, erection, alteration or repair in, or in land adjacent to, the said lengths of road or side of road of any sewer or of any main, pipe or apparatus for the supply of gas, water or electricity or of any telegraphic line as defined in the Telegraph Act 1878;
 - (c) the vehicle, if it cannot conveniently be used for such purpose in any other road, to be used in the service of a local authority or water authority in pursuance of statutory powers or duties;

(d) the vehicle to be used for the purpose of delivering or collecting postal packets as defined in Section 87 of the Post Office Act 1953; or

(e) the vehicle to take in petrol, oil, water or air from any garage situated on or adjacent to the said lengths of road or side of road.


(2) Nothing in Article 4 of this Order shall render it unlawful to cause or permit any vehicle to wait for so long as may be necessary for the purpose of enabling goods to be loaded on or unloaded from the vehicle.

(3) Nothing in Article 4 of this Order shall render it unlawful to cause or permit any vehicle being a hackney carriage, to wait upon an authorised cab rank.

(4) Nothing in Article 4 of this Order shall render it unlawful to cause or permit a disabled person's vehicle which displays in the relevant position a disabled person's badge, and a parking disc (on which the driver, or other person in charge of the vehicle, has marked the time at which the period of waiting began) to wait in any of the lengths of road or on the side of road referred to in those Articles for a period no exceeding two hours (not being a period separated by an interval of less than one hour from a previous period of waiting by the same vehicle in the same length or on the same side of road on the same day).

6. The prohibitions and restrictions imposed by this Order shall be in addition to and not in derogation from any restriction or requirement imposed by any regulations made or having effect as if made under the Act or by or under any other enactment.

THE COMMON SEAL OF THE BOROUGH
COUNCIL OF TEST VALLEY was
hereunto affixed the 8th
day of JUNE 1990
in the presence of:-

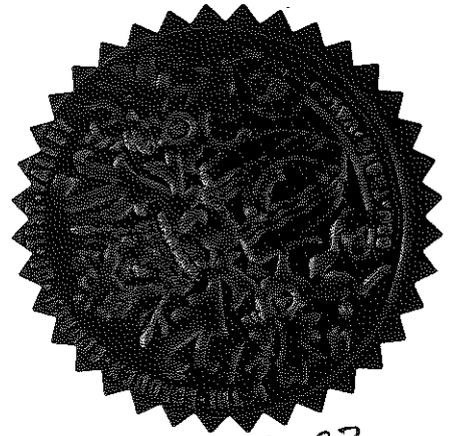

Mayor *Paula D. White*

12092

ASSISTANT SECRETARY *[Signature]*
~~Borough Secretary and Solicitor~~

Beech Hurst
Weyhill Road
Andover
Hants

SCHEDULE 1

PART 1

ORDER

EXTENT OF REVOCATION

The Hampshire, Andover
(Prohibitions of Waiting)
Order 1971

The deletion of Western Distributor
Road

Test Valley Borough Council
(Various Roads, Andover)
(Prohibition and Restriction
of Waiting) (No.2) Order
1977

Deletion of Osborne Road in Schedule
I

The Borough of Test Valley
(Prohibition and Restriction
of Waiting) Order 1985

The deletion of Alexandra Road
and Croye Close in Schedule 2

PART 2

ORDER

EXTENT OF AMENDMENT

Test Valley Borough Council
(Various Roads, Andover)
(Prohibition and Restriction
of Waiting) (No.2) Order 1977.

Deletion of the entry in Schedule II
under "High Street (b)" of the words
"but with four member disabled
drivers spaces provided on the
western side of the Guildhall" and
the substitution therefor of the
following words "including both
sides of the turning area
immediately south of the Guildhall
forecourt".

SCHEDULE 2

To prohibit waiting at any time on any day in the following lengths of roads in Andover:-

Alexandra Road, Andover

- Revoked
01/12/2003
- (a) On its east side for a distance of 15 metres on either side of its junction with Osborne Road;
 - (b) On its west side from a point 15 metres south of its junction with Osborne Road for a distance of 42 metres northwards to a point 15 metres north of its junction with Osborne Road.

Black Swan Yard Service Road

The highway land at the rear of numbers 48 and 48a High Street, Andover.

Enham Lane, Charlton

Revoked by
AHM 2016

On both sides from the Hatherden Road, northwards and north easterly to a point 15 metres northwards of its junction with St Thomas Close, a distance of 165 metres, including the bus layby.

Junction Road

Revoked
17/11/2006

- (a) On its east side from its junction with Charlton Road, southeastwards to its junction with Crossway, a distance of 90 metres.
- (b) On its west side from its junction with Charlton Road, southeastwards to its junction with Station Approach, a distance of 70 metres.

Osborne Road

Revoked
21/03/2005

- (a) On both sides for a distance of 15 metres in an easterly direction from its junction with Alexandra Road.
- (b) On its north side from its junction with Junction Road westwards to its junction with Balmoral Road, a distance of 80 metres.
- (c) On its south side from its junction with Junction Road westwards for a distance of 90 metres.

Western Avenue

Both sides of Western Avenue from its junction with Bridge Street, northwards for a distance of 162 metres.

adcu/rtos/perm/notices/provarious

SCHEDULE 3

To prohibit waiting on any day between 9.00am and 6.00pm in the following lengths of roads in Andover:-

Revoked by
A12-3

Adelaide Road

On both sides between the Borough Arms Public House and East Street, except for the length referred to in Schedule 4.

Revoked
01/12/2003

Dene Road

- (a) On its west side from the end of the existing waiting restriction southwards and eastwards for a total distance of 75 metres.
- (b) On its east side from the end of the existing waiting restrictions and southwards for a distance of 60 metres.

SCHEDULE 4

To restrict waiting to a period of one hour in any two hours between the hours of 9.00am and 6.00pm on any day other than a Sunday in the following length of road:-

Revoked by
A12-3

Adelaide Road, Andover

A length of 50 metres in front of the Borough Arms Public House.

SCHEDULE 5


To prohibit the waiting between the hours of 2.30pm and 3.15pm on any day other than Saturdays and Sundays in the following lengths of roads:-

Alexandra Road, Andover

On both sides from a point opposite the boundary between Numbers 13 and 15 Alexandra Road, northwards and westwards for a distance of 83 metres to its junction with Croye Close.

Croye Close, Andover

On both sides in a northerly direction from its junction with Alexandra Road for a distance of 46 metres to a point opposite the north-west boundary of Number 3 Croye Close.

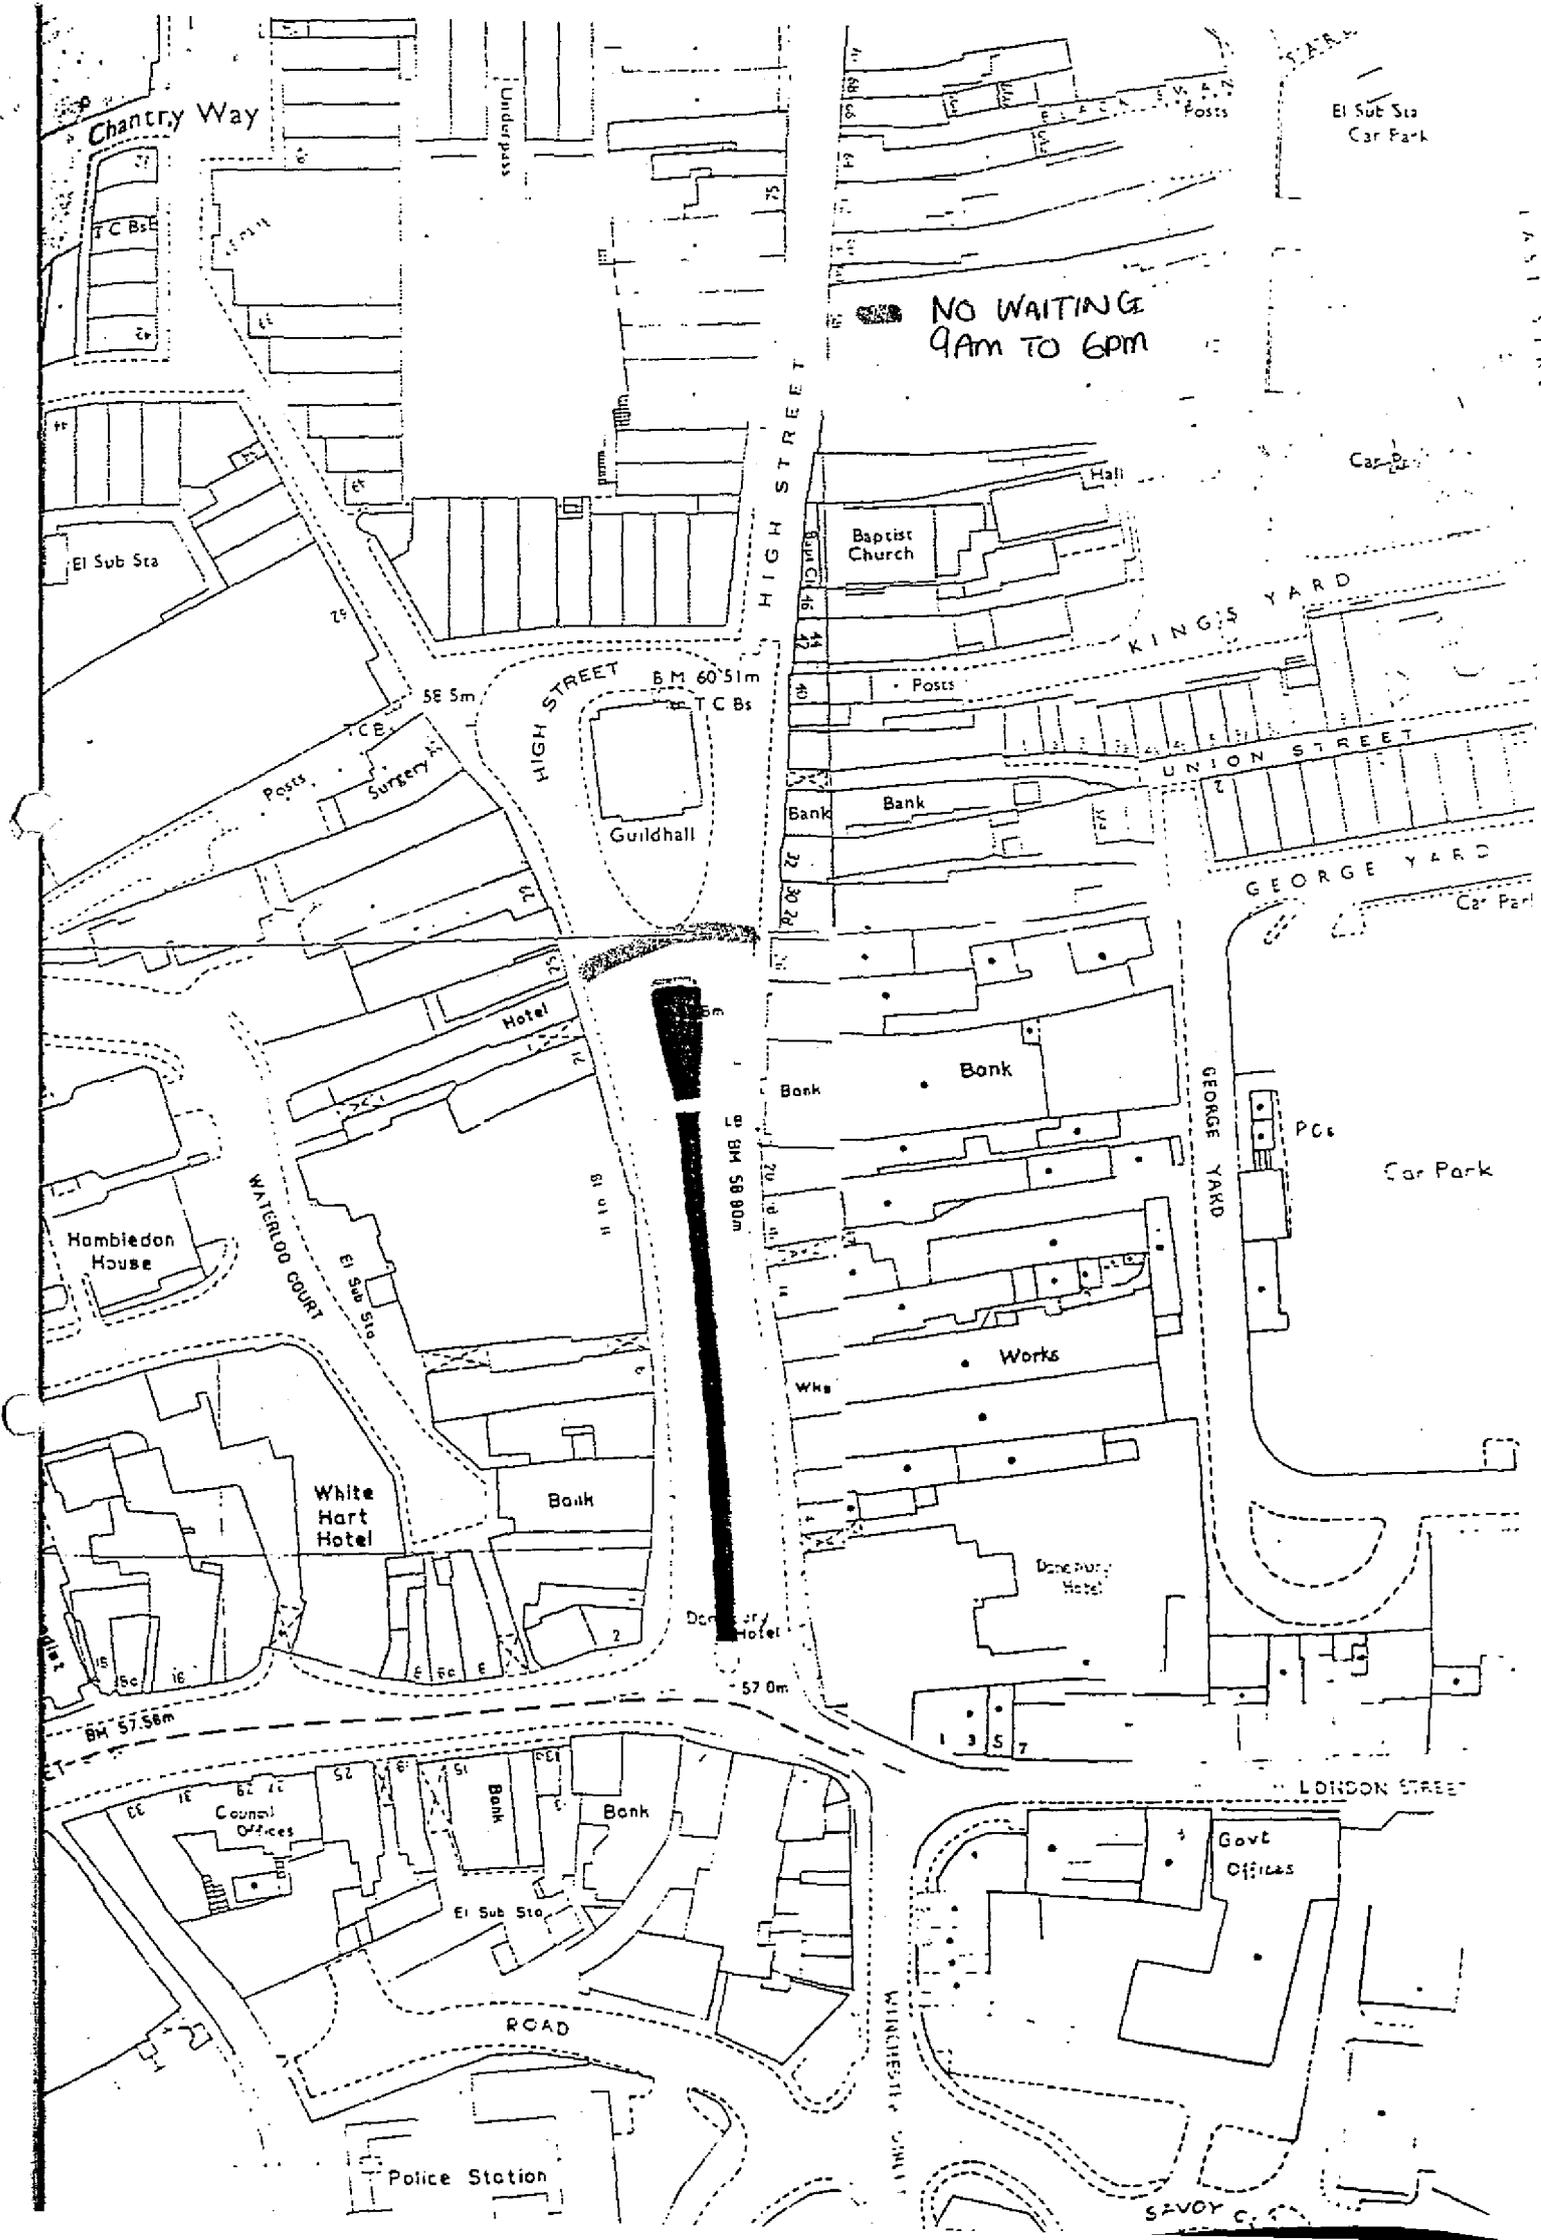

NO WAITING
9AM TO 6PM

Chantry Way

HIGH STREET

KING'S YARD

UNION STREET

GEORGE YARD

LONDON STREET

SAVOY COURT

T.C. B's

El Sub Sta

Hambledon House

White Hart Hotel

Council Offices

Police Station

Guildhall

Baptist Church

Hotel

Bank

Works

Bank


Bank

Bank

Govt Offices

El Sub Sta
Car Park

Car Park

Car Park

Car Park

Car Park

ROAD


B.M. 60.51m

B.M. 58.80m

57.0m

B.M. 57.58m

SE 5m

51.10.11

Wks

P.C.

Hall

Posts

Posts

Surgeries

Bank

Bank

Bank

Wks

1 3 5 7

MINCHINGHAM

HIGH STREET

WATERLOO COURT

El Sub Sta

Bank

El Sub Sta

Dorset Hotel

Dorset Hotel

Govt Offices












































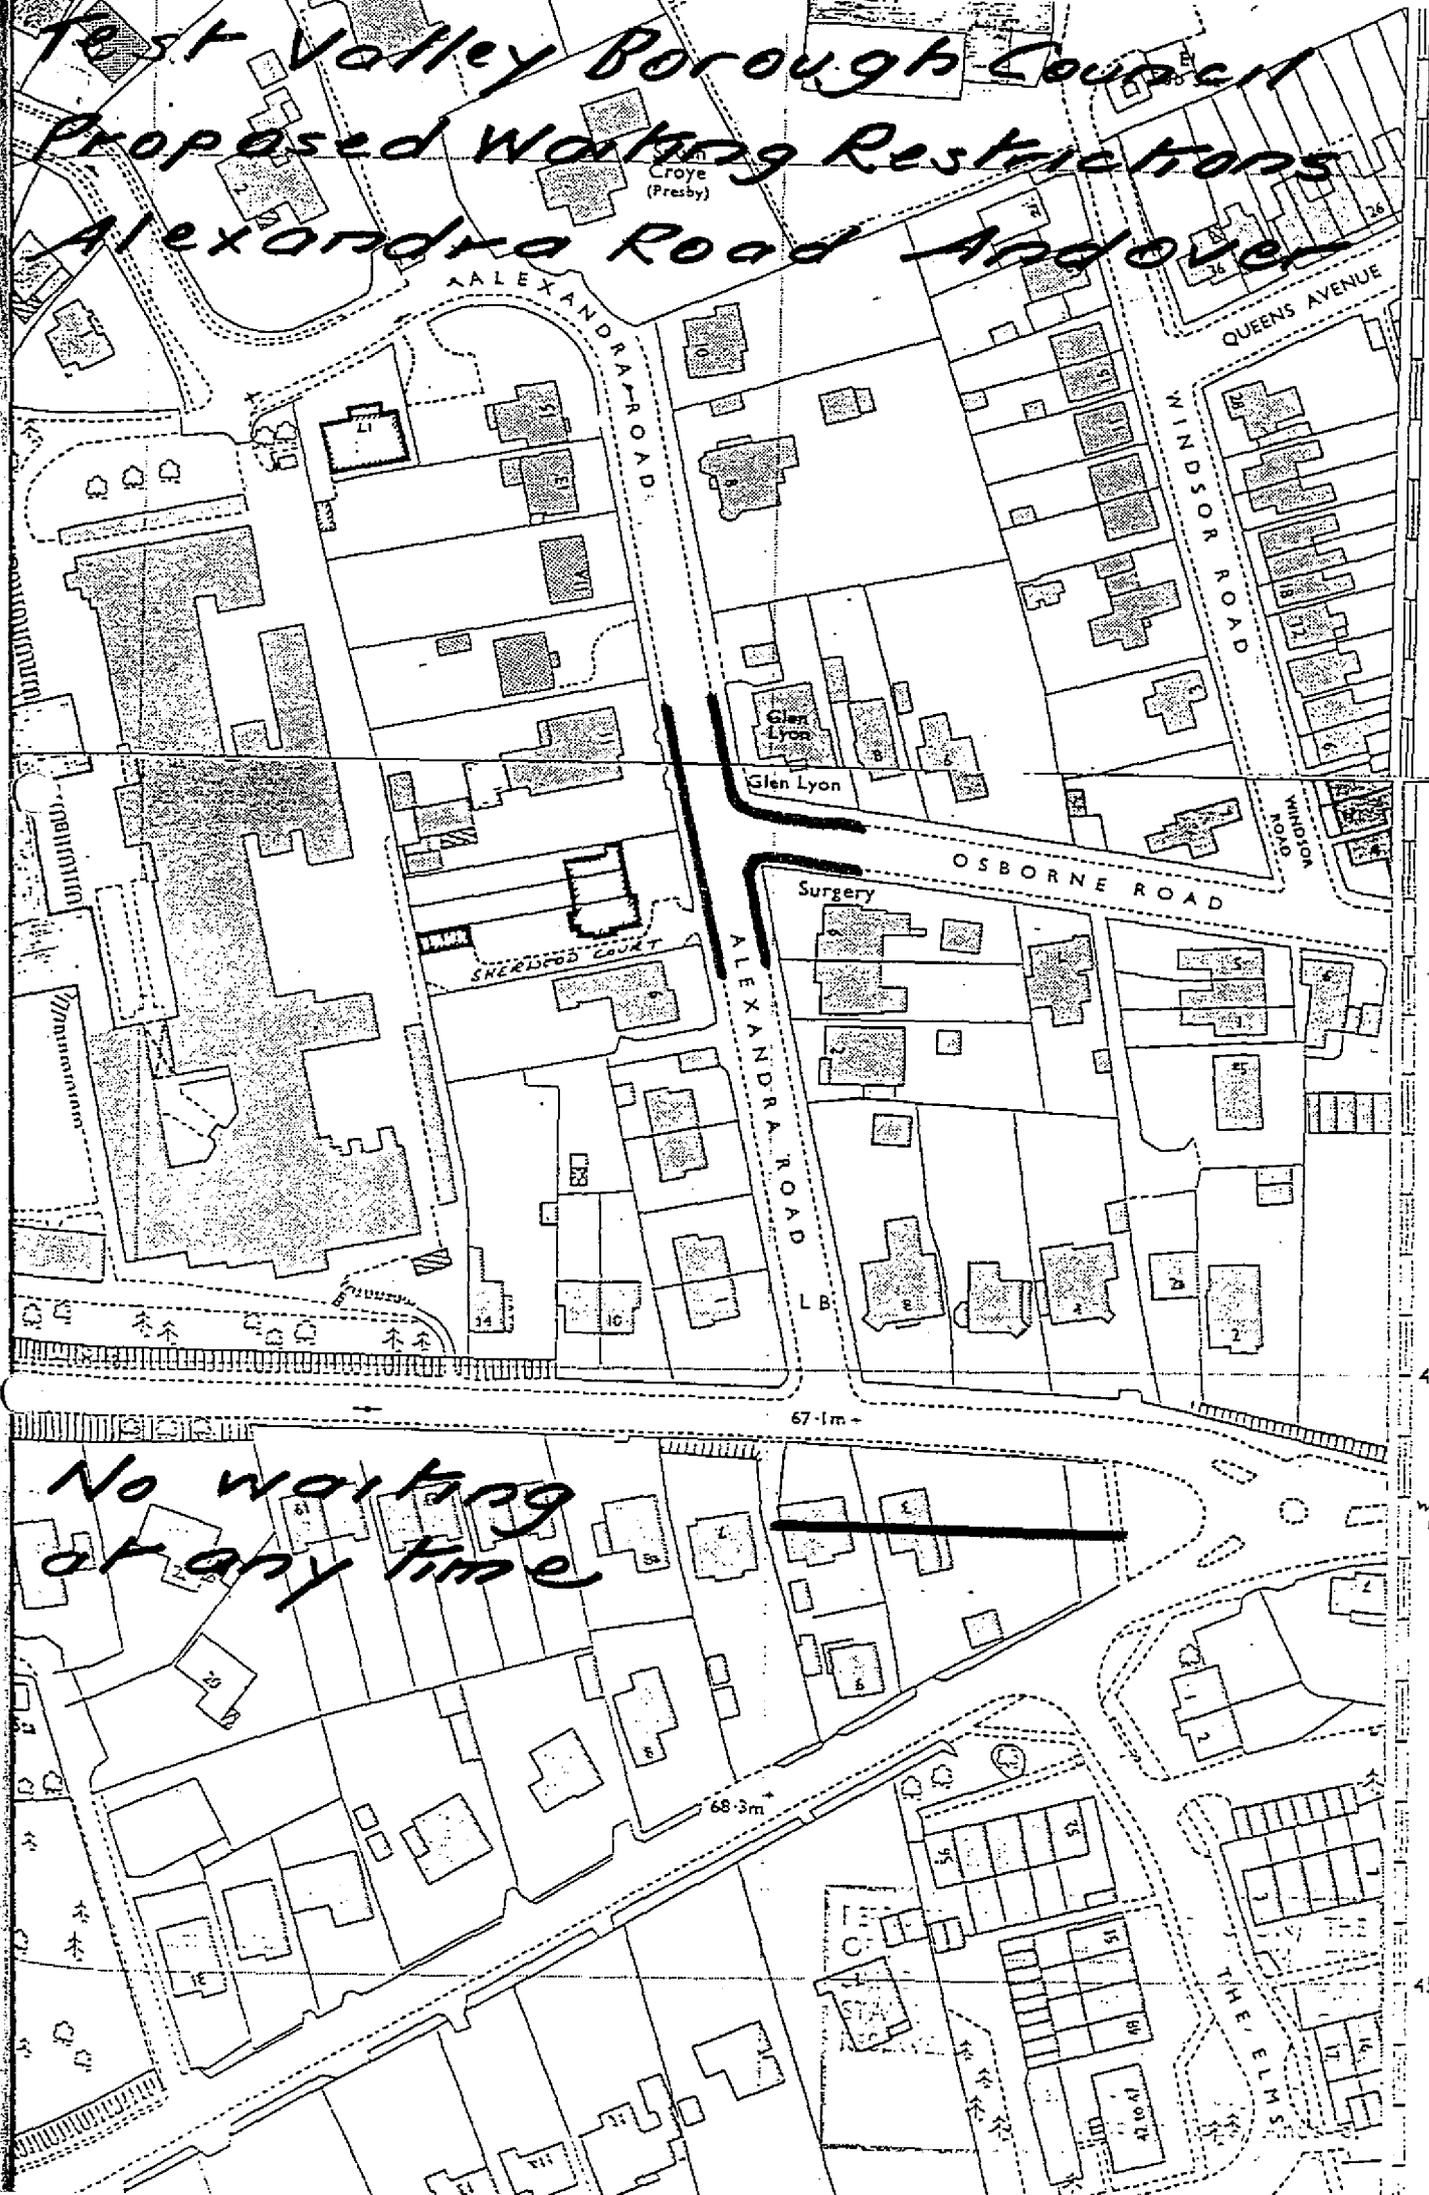

456

455

454

WEST RD.

452

*No waiting
at any time*

67-1m

68-3m

Croye
(Presby)

Glen Lyon

Glen Lyon

Surgery

L.B.

QUEENS AVENUE

WINDSOR ROAD

OSBORNE ROAD

ALEXANDRA ROAD


ALEXANDRA ROAD


WINDSOR ROAD

THE ELMS

WEST RD.

Original

Test Valley Borough Council Proposed Waiting Restrictions Enham Lane Charlton

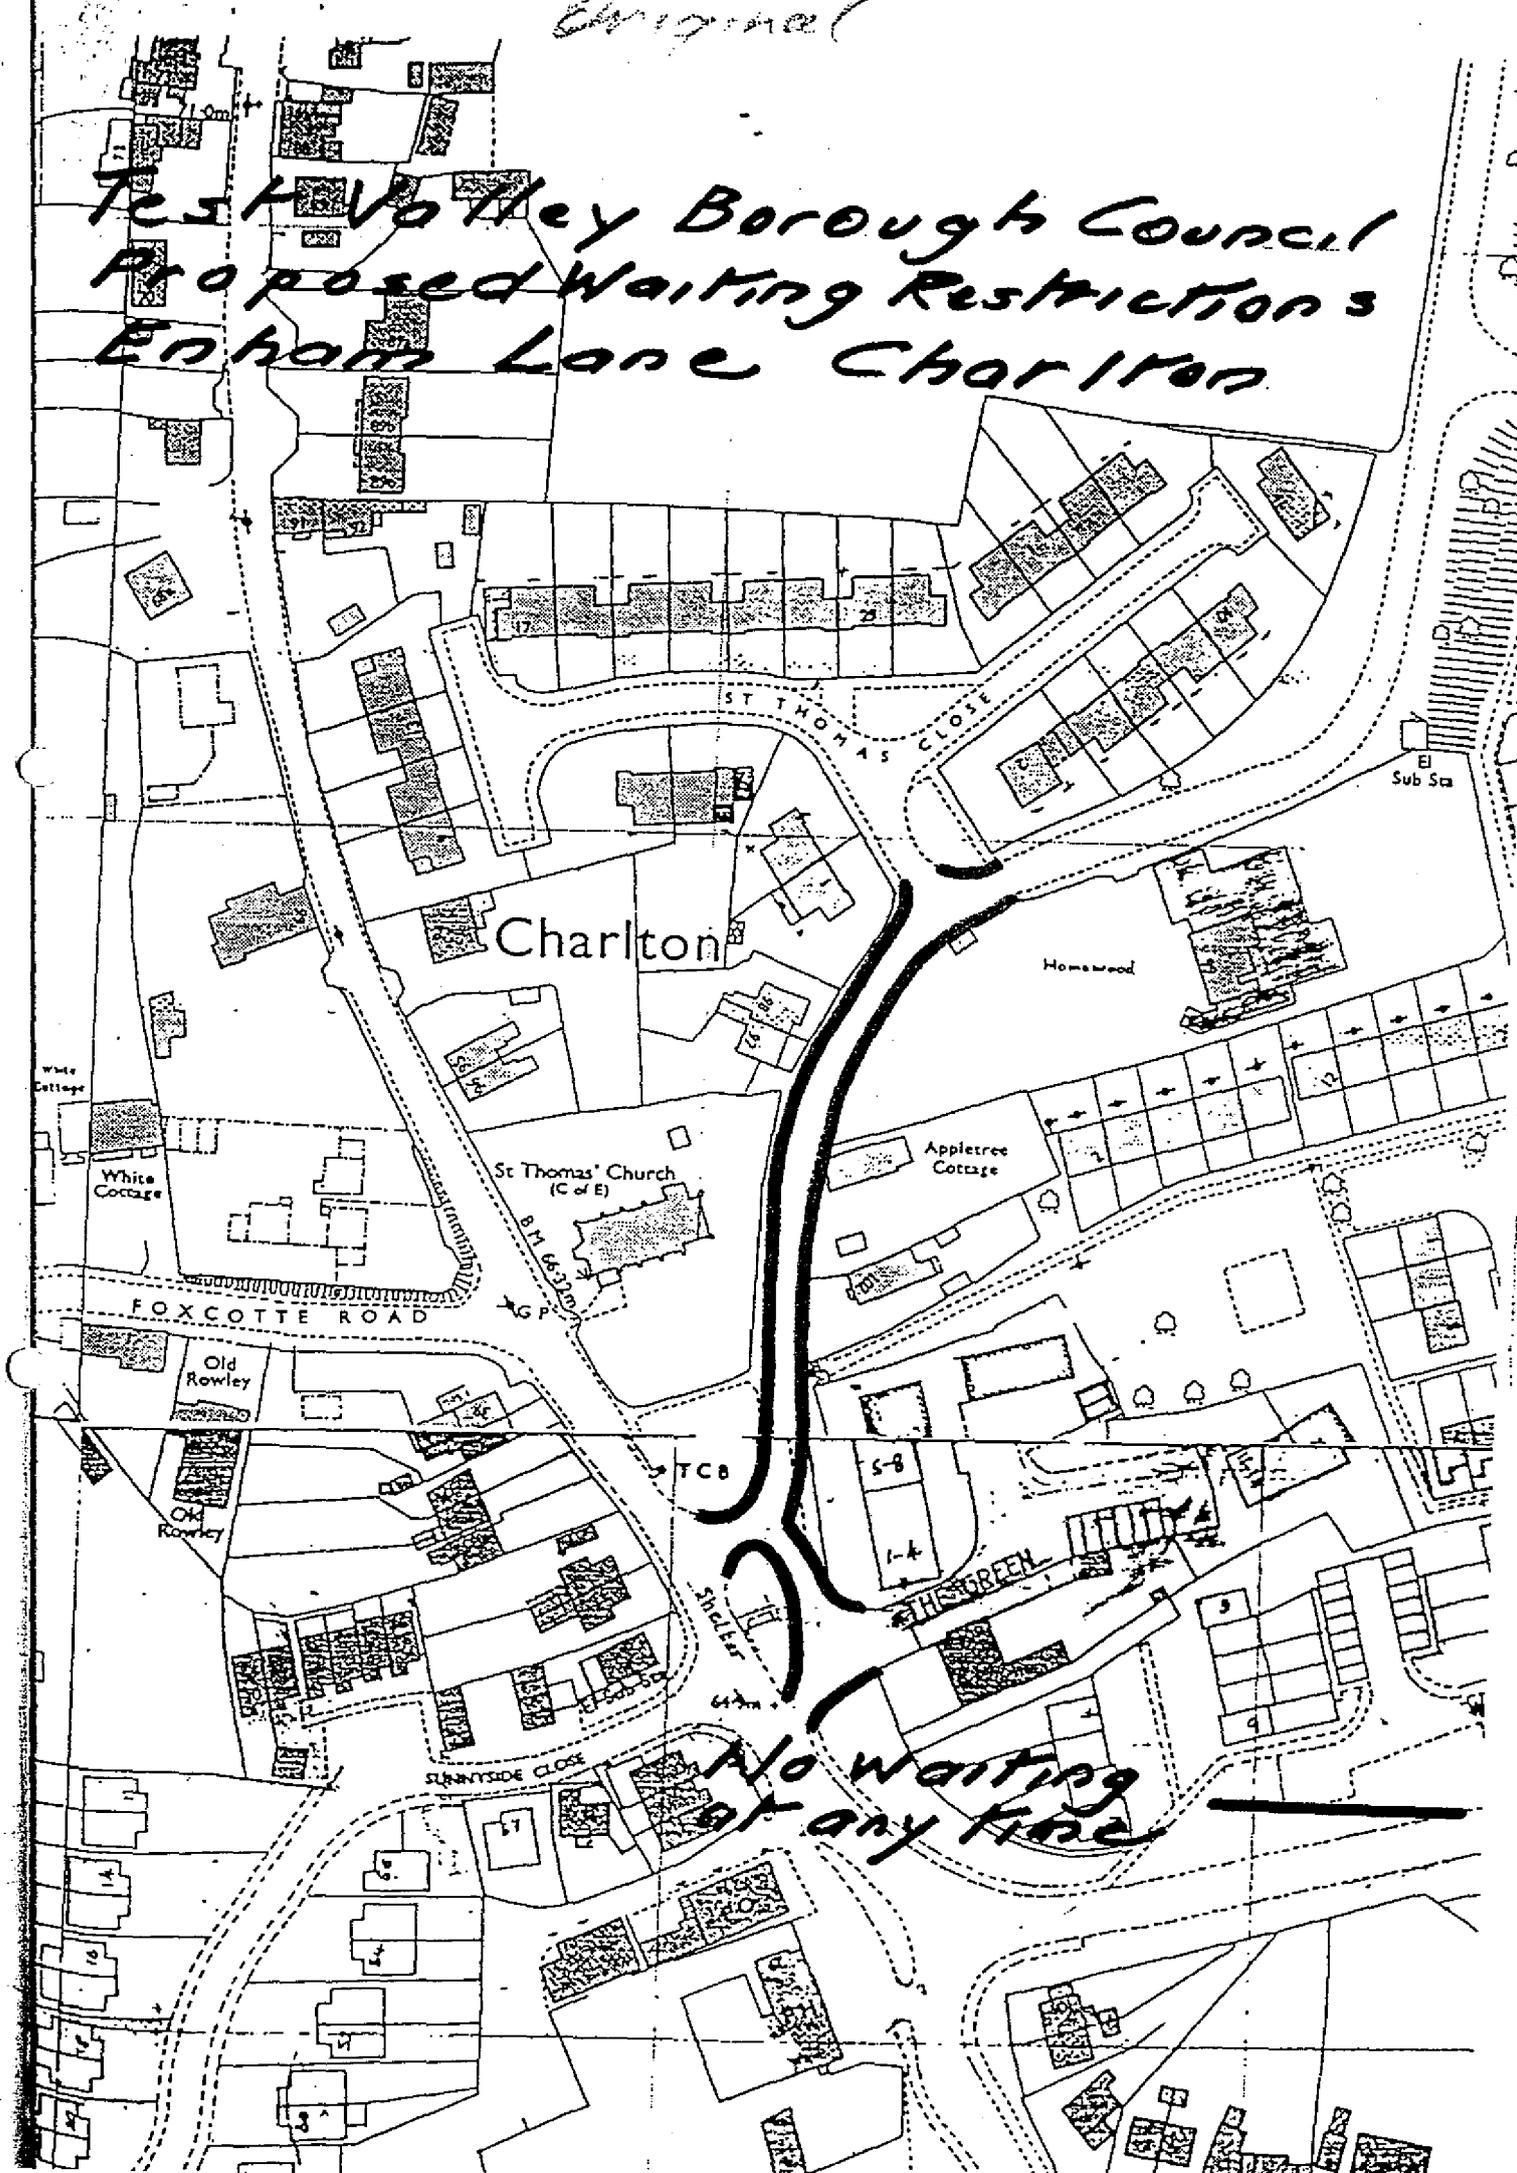

**No waiting
at any time**
























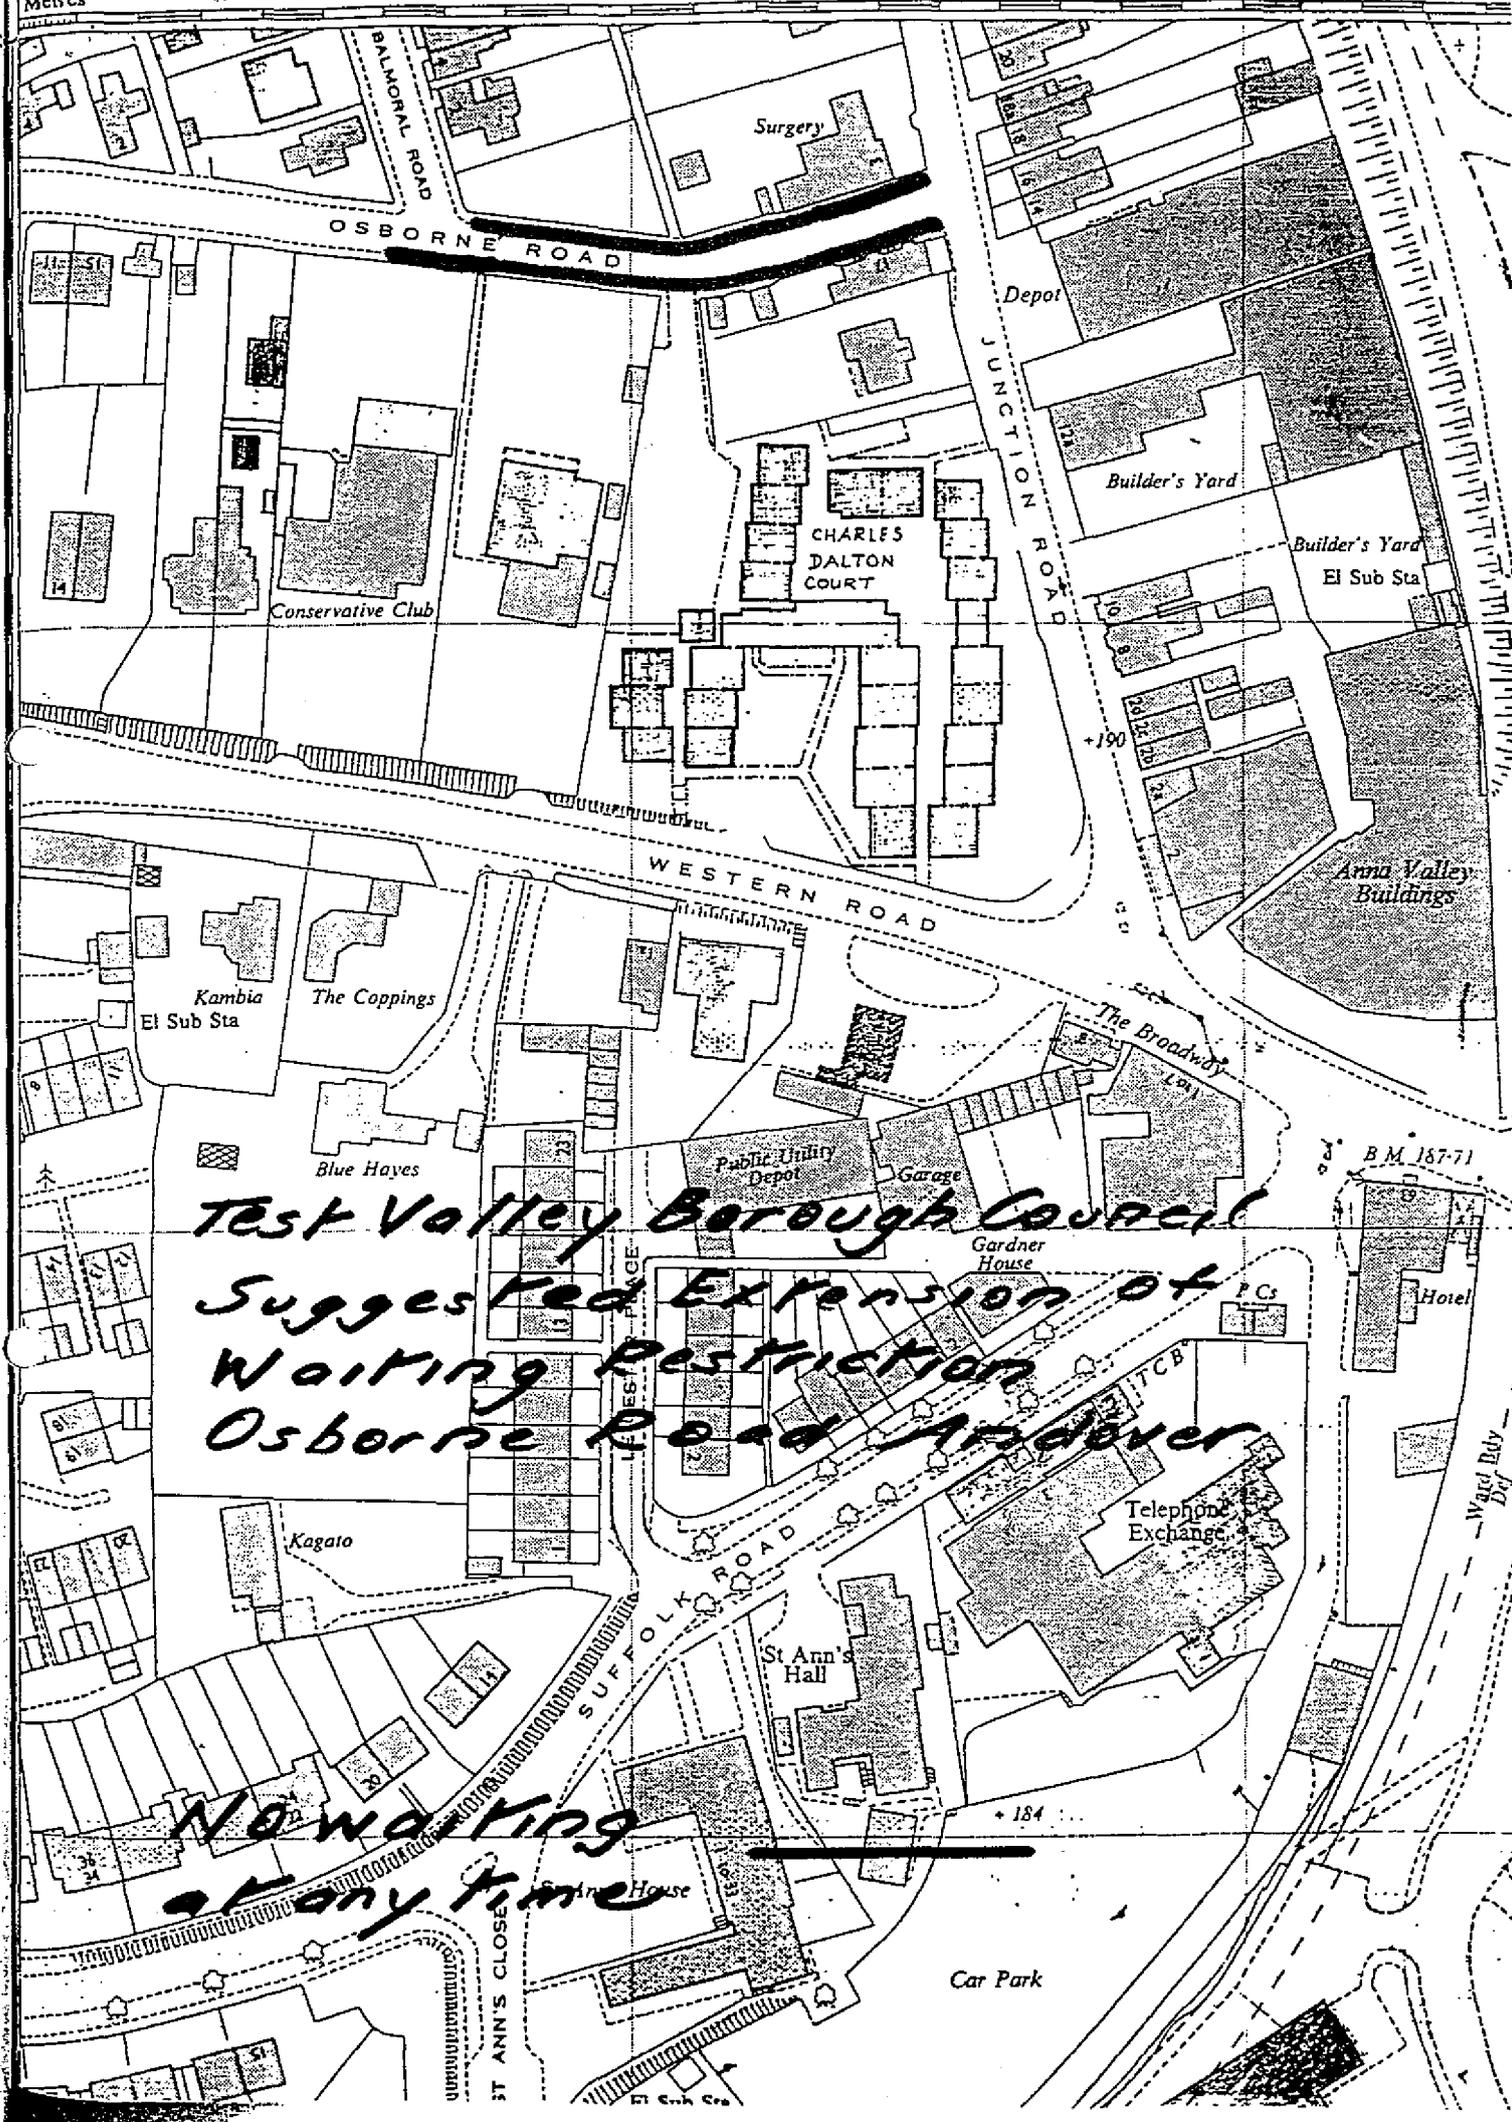

*Test Valley Borough Council
Suggested Extension of
Waiting Restriction
Osborne Road Andover*

*No waiting
at any time*

+184

Car Park

B.M. 187-71


ST ANN'S CLOSE

House

El Sub Sta

P.C.s

TCB

Telephone Exchange

St Ann's Hall

Gardner House

Garage

Public Utility Depot

Blue Hayes

Kambia El Sub Sta

The Coppings

+190

Anna Valley Buildings

Builder's Yard
El Sub Sta

Builder's Yard

Depot

Surgery

CHARLES DALTON COURT

Conservative Club

OSBORNE ROAD

BALMORAL ROAD


JUNCTION ROAD

WESTERN ROAD

The Broadway

SUFFOLK ROAD



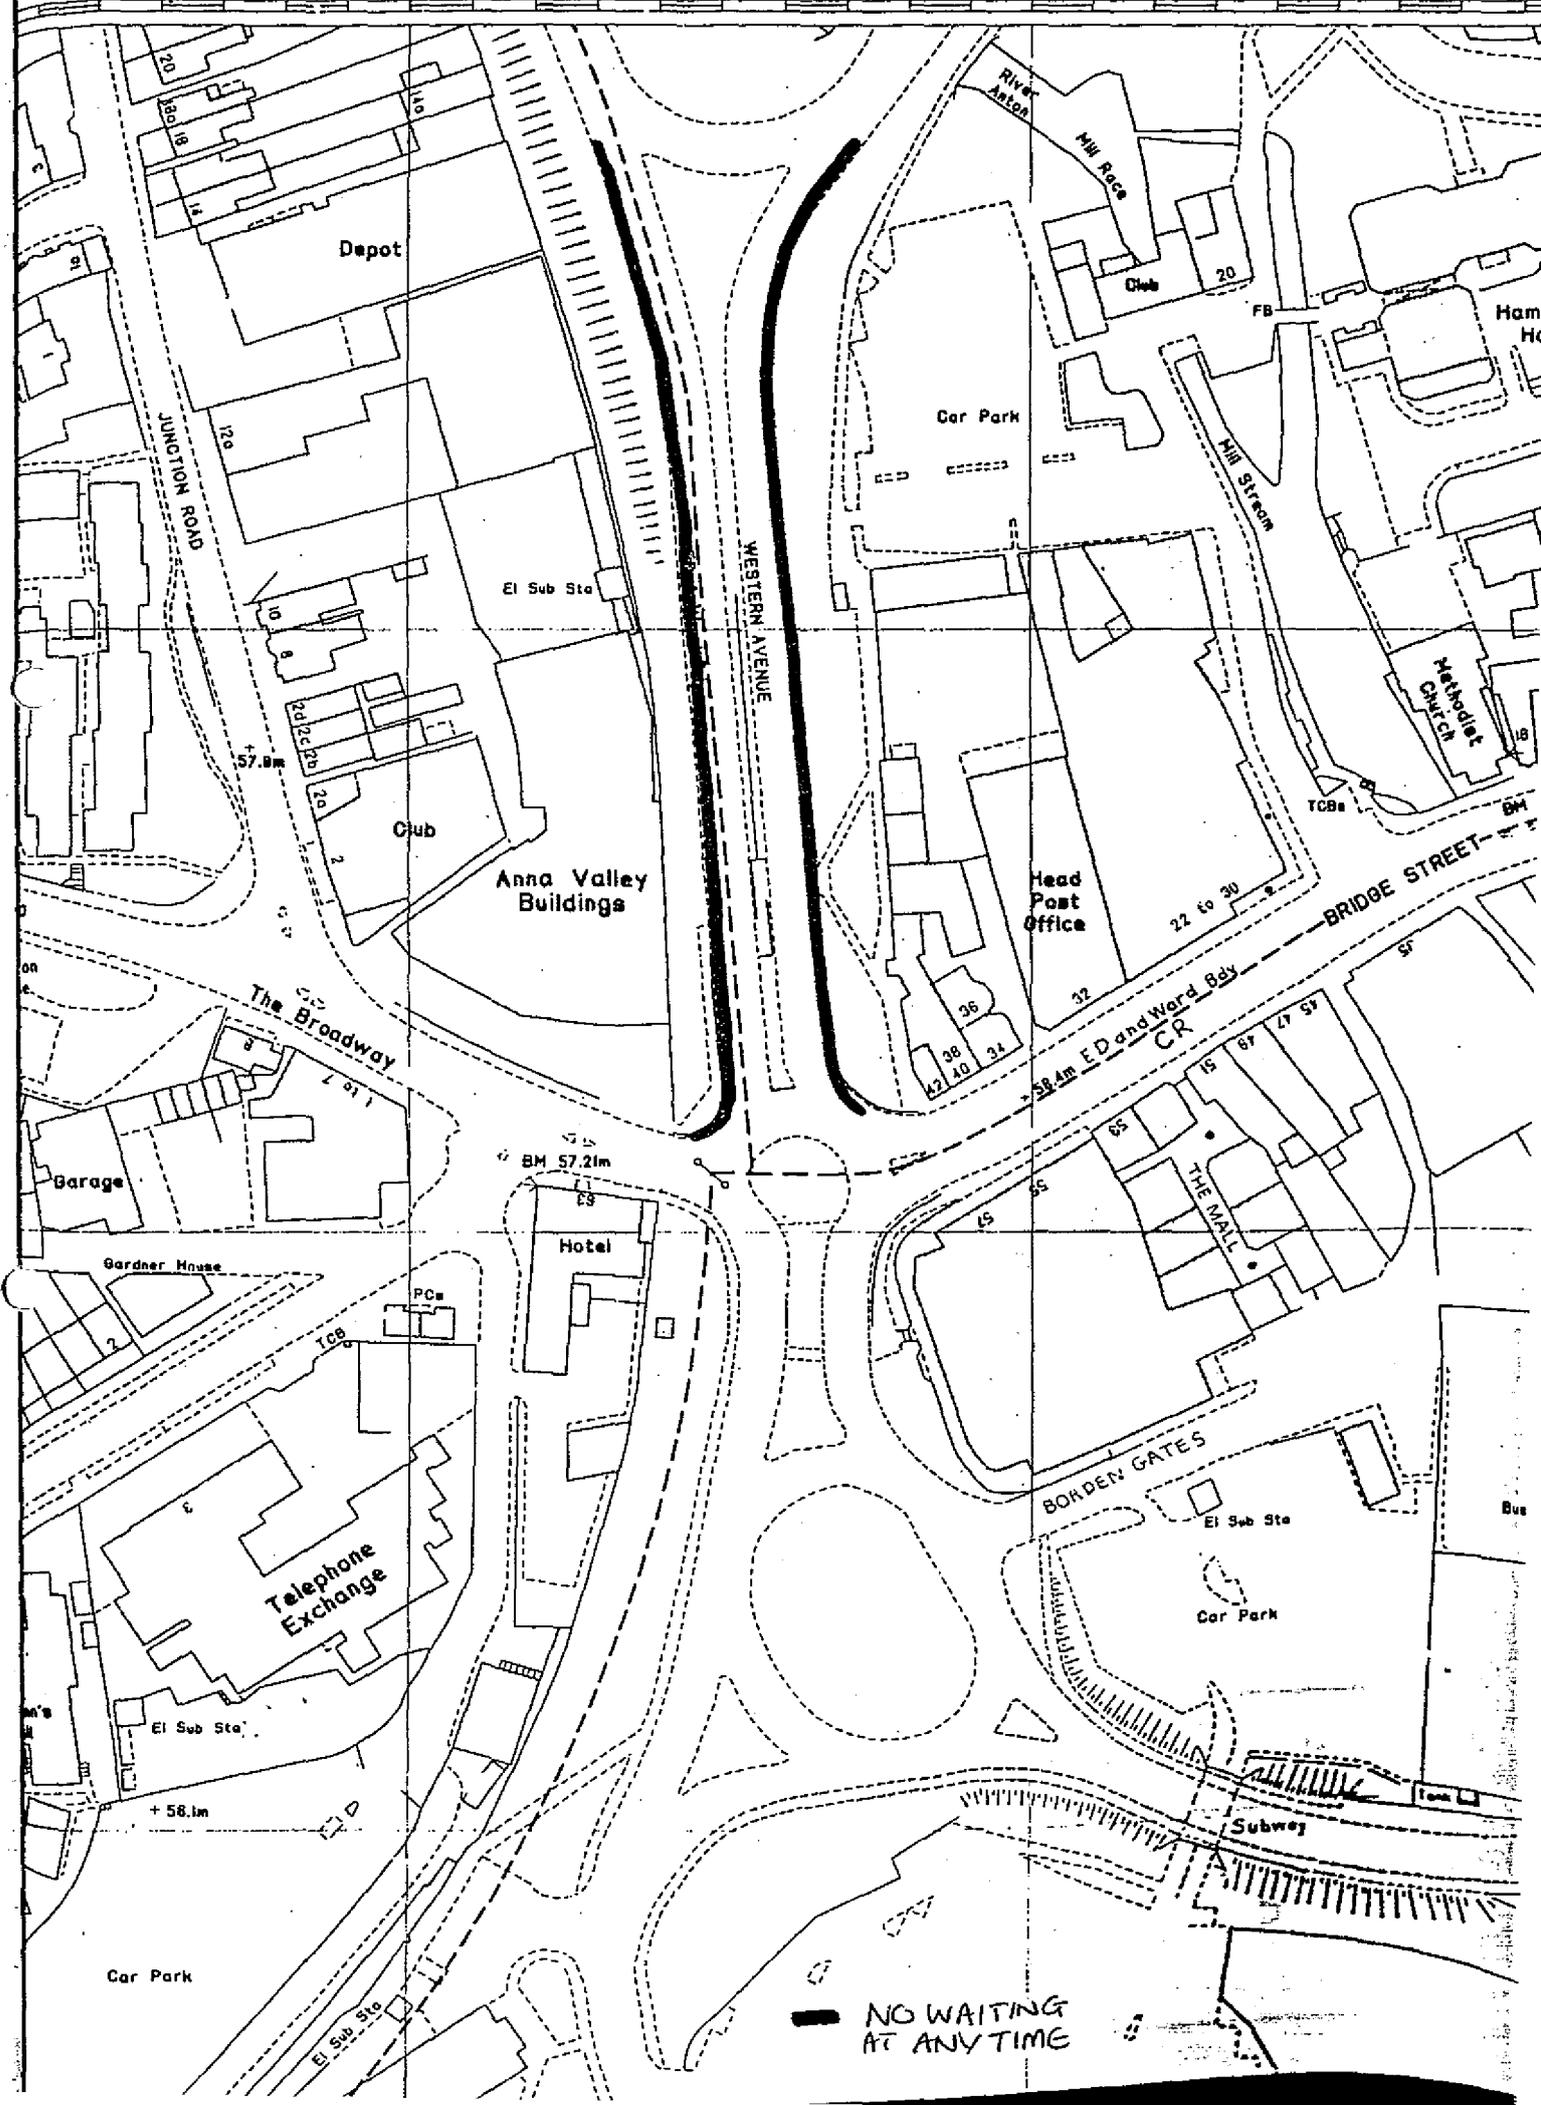

**NO WAITING
AT ANY TIME**

**West Valley Borough Council
Proposed Waiting Restrictions
Alexandra Road - Croye Close Andover**

**No Waiting
2:30pm - 3:15pm
Mondays - Fridays**

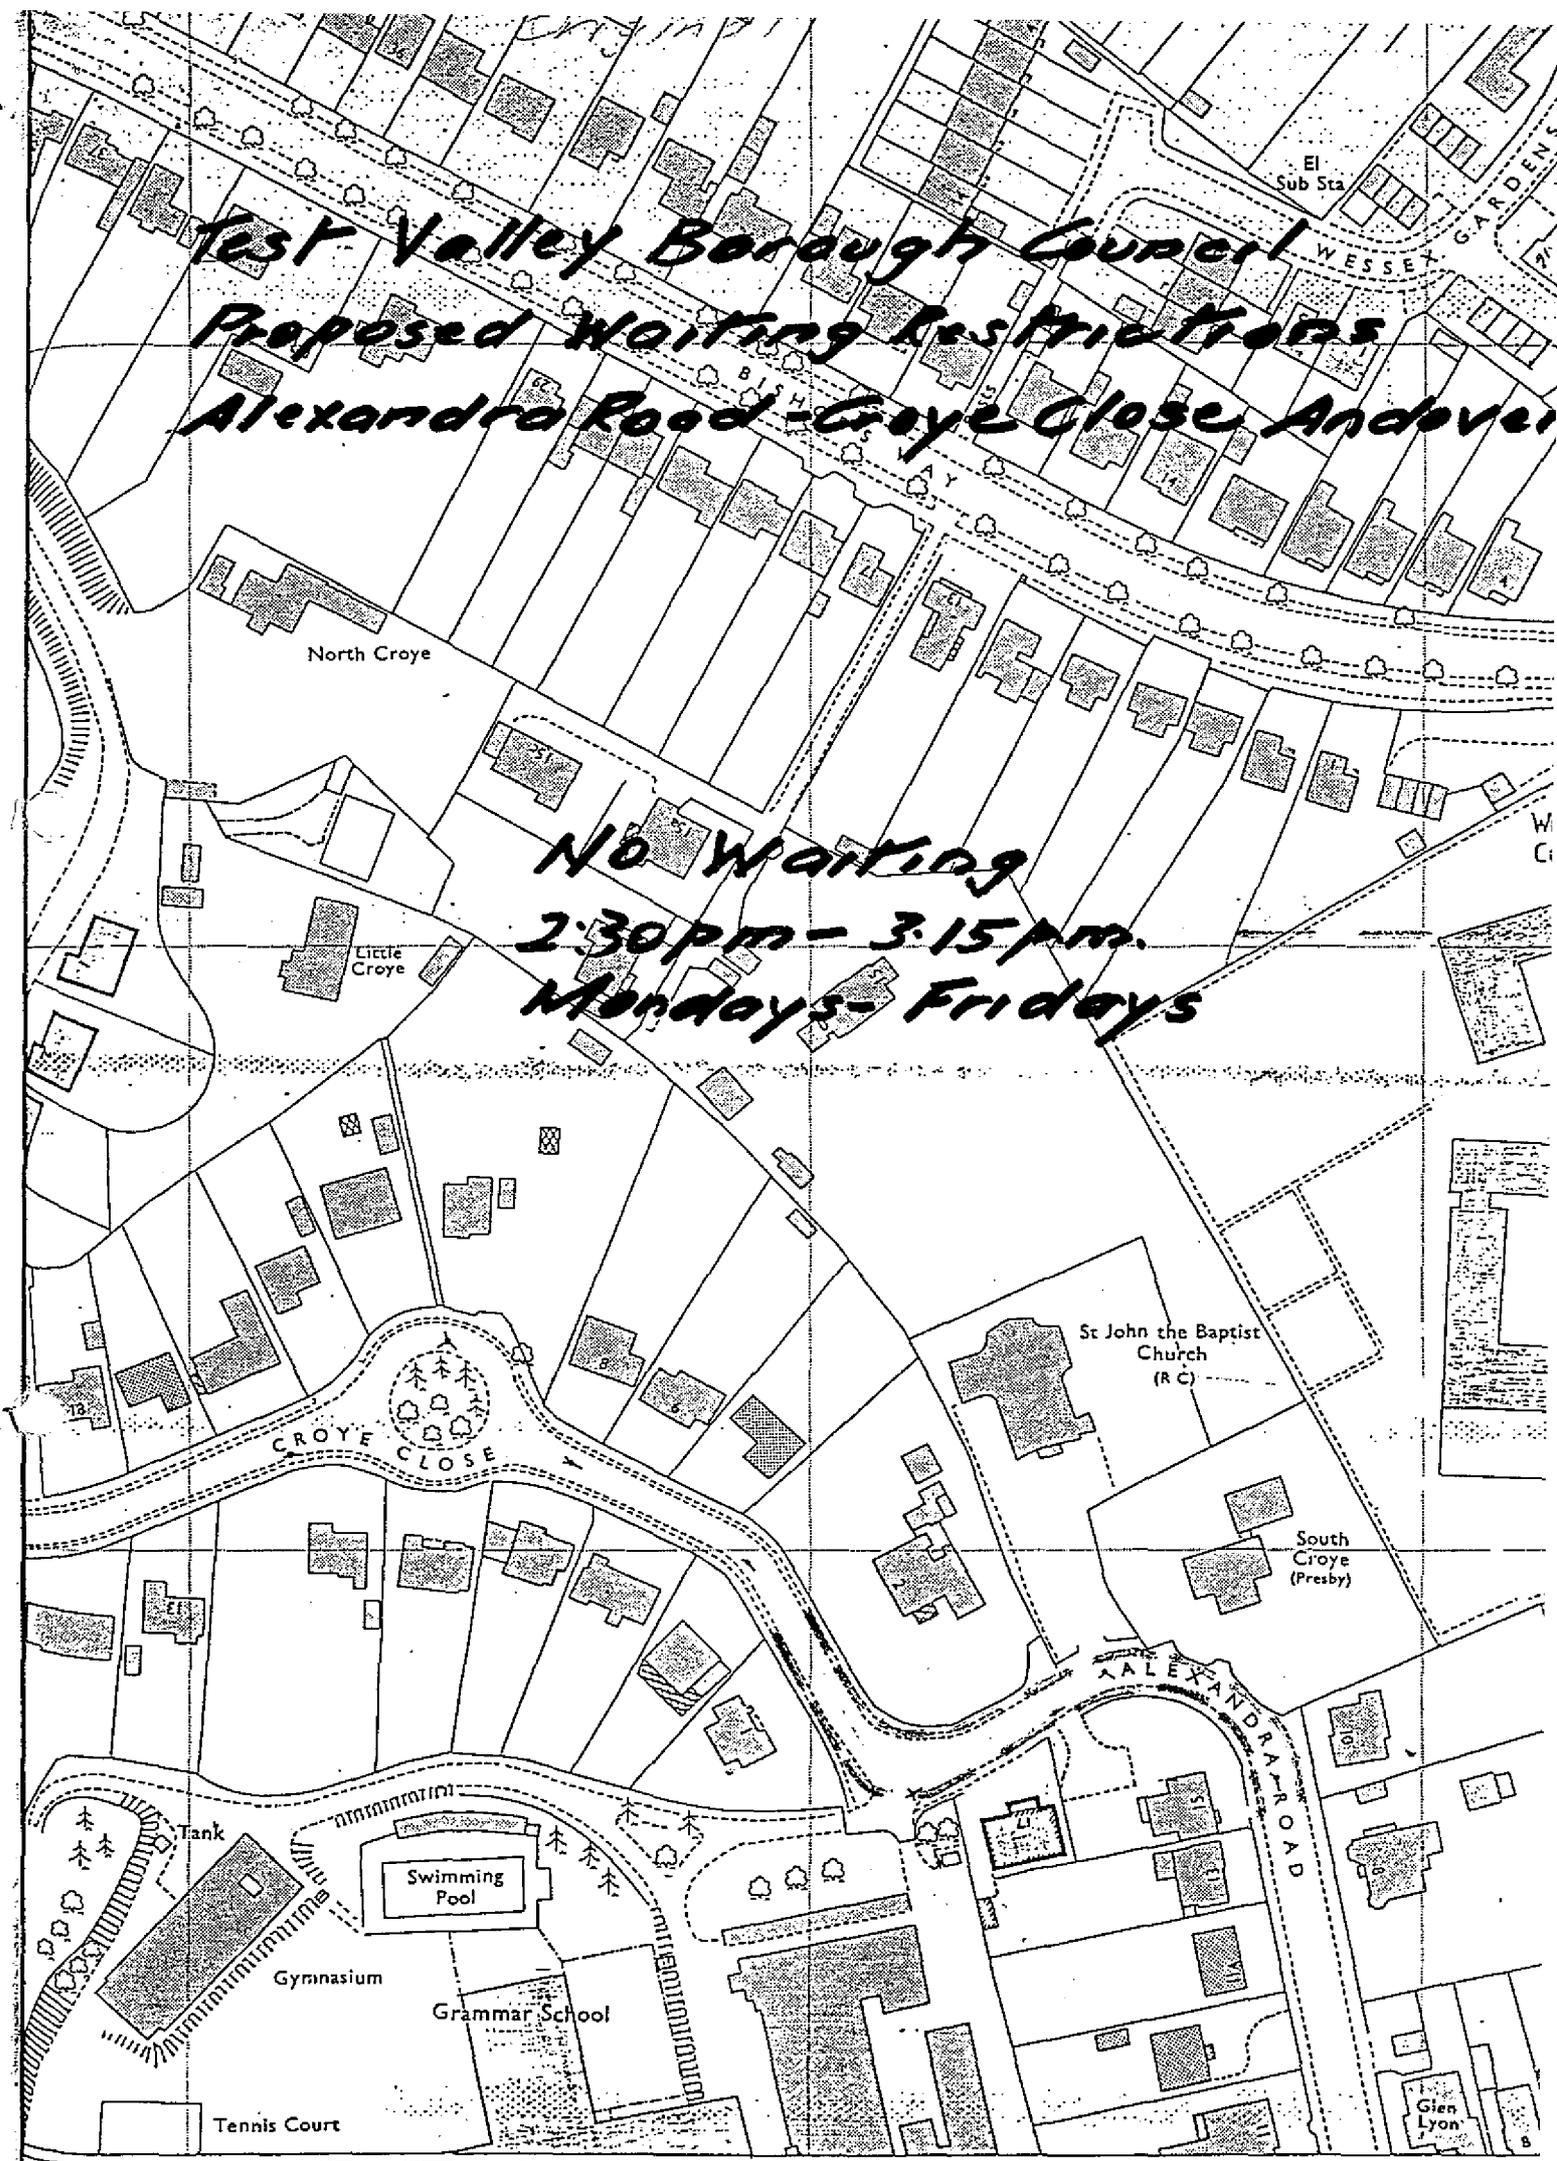

El Sub Sta

WESSEX GARDENS

North Croye

Little Croye

CROYE CLOSE

St John the Baptist Church (R.C.)

South Croye (Presby)

Tank

Swimming Pool

Gymnasium

Grammar School

Tennis Court

ALEXANDRA ROAD

Glen Lyon

Test Valley Borough Council
Proposed Waiting Restrictions




No waiting
9.00 am - 6.00 p.m.
Mondays - Saturdays


Waiting limited to
1 hour in any 2 hours
9.30 am - 6.00 p.m.
Mondays - Saturdays

Original

End of existing Waiting Restriction



No Waiting
9.00am - 6.00p.m.
Mondays - Saturdays

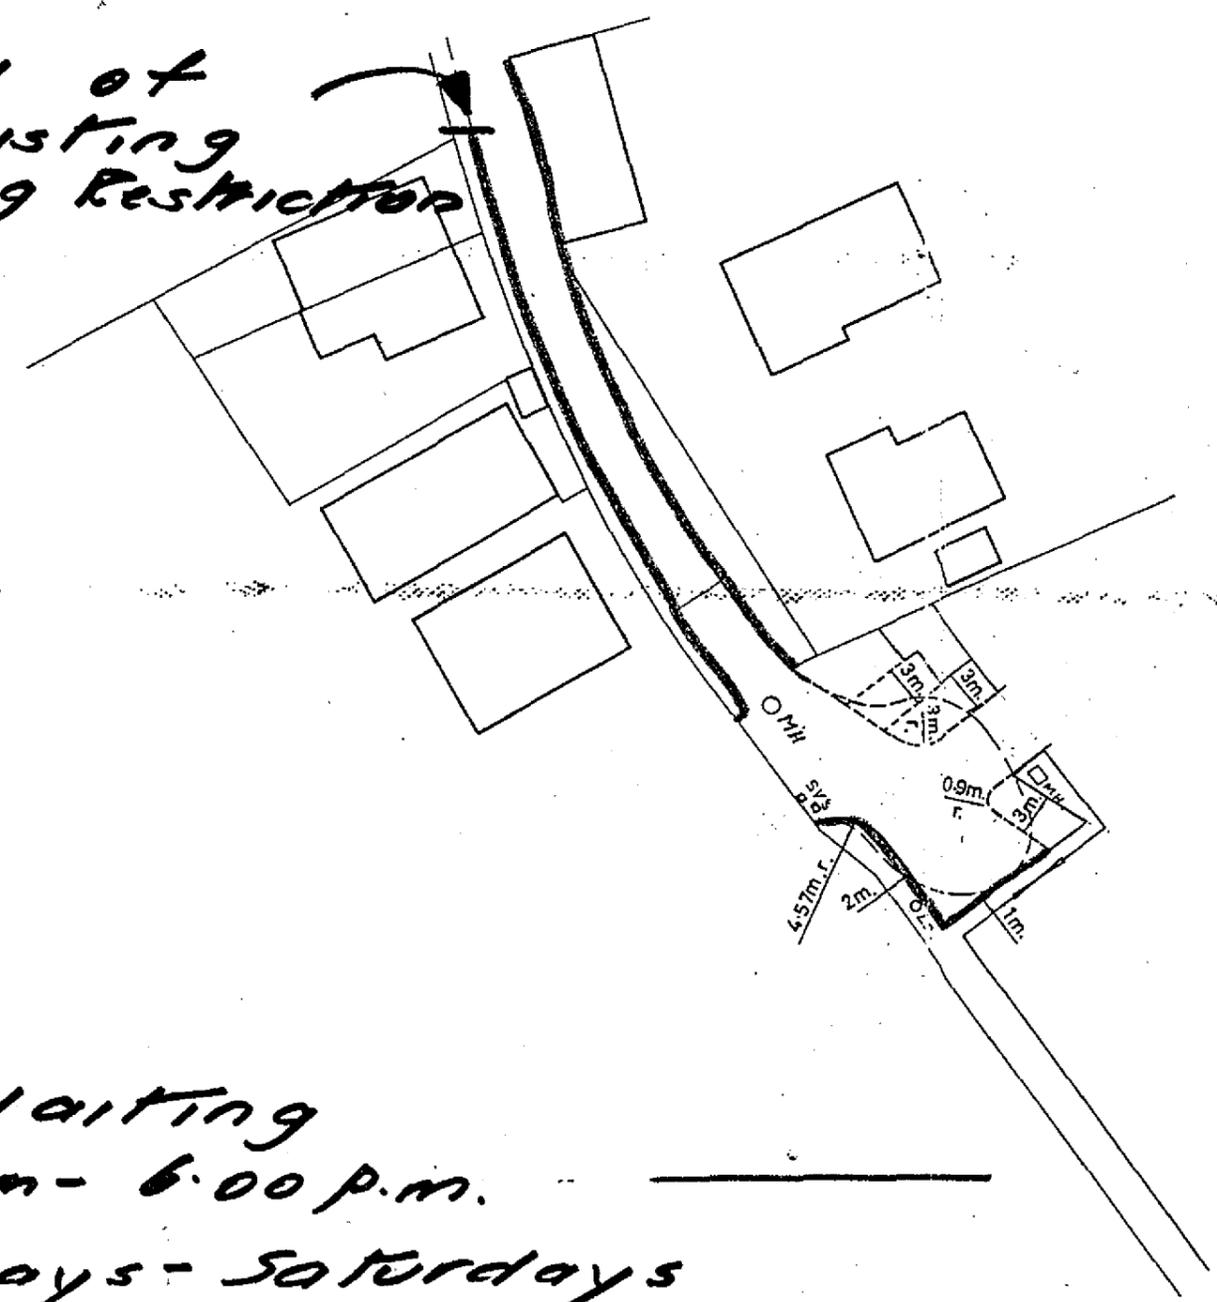

- Notes**
-  Area to have a construction depth of 450 mm.
 -  Area to have a construction depth of 300mm.
 -  Area to be resurfaced only.
 -  Footway construction

TV **TEST VALLEY**
BC **BOROUGH COUNCIL**
TECHNICAL SERVICES DEPARTMENT
JUNCTION ROAD ANDOVER
Chief Technical Officer
M. Orchard B.Sc.(Hons) C.Eng. M.I.C.E.
M.I.Mun.E., M.I.H.E.

Contract
Dene Road. Provision of
Turning and Car Parking
Facilities.

Title

Layout Plan

Scale 1/500	Job No T/2/1
Drawn M.D.	Sheet No 5
Date July, 1987	